


Section 4 Township 21 Range 13 W

Well No. # 2 Willcutt "B"

Company H. D. Kaiser

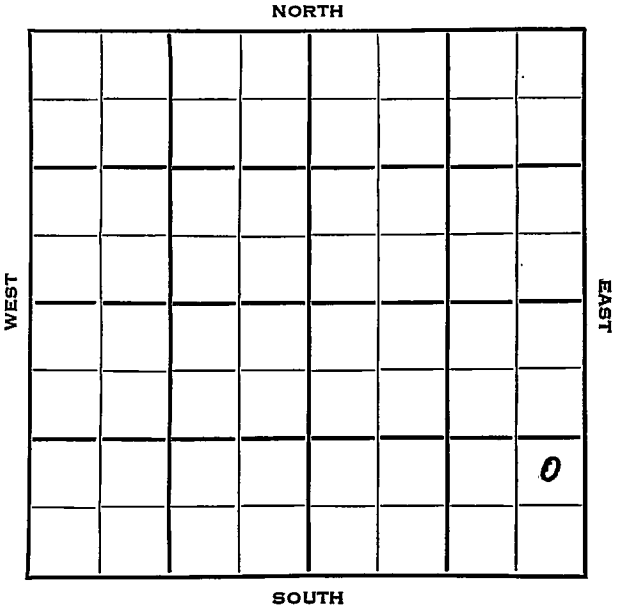

Stafford **KANSAS**


SEC.	TWP.	R.
4	21	13 W ✓

WELL NO. # 2 Willcutt "B" FARM

COMPANY H. D. Kaiser

CONTRACTOR Hilton Drlg.
Shaffer Pool

_____ Ft. from N. Line
 990 _____ Ft. from S. Line
 330 _____ Ft. from E. Line
 _____ Ft. from W. Line

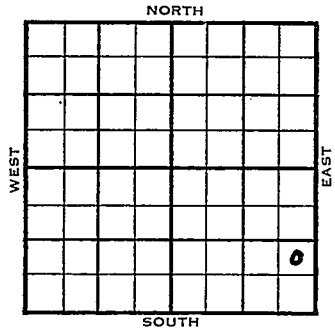

NE SE SE

	ELEVATION	REPORT
1953	1886'	
10/14	Spud 10-10-53 8" @ 214 Drlg. 676'	
10/21	Drlg. 3340'	
10/28	Br li 3261', KC 3274 RTD 3580' 5" @ 3507'	
11/4	CO 3472' 24/3346-52, FU 2150' oil S/25 boph	
11/11	NR	
11/18	"	
12/9	"	
12/22	Spud 10-10-53 Oil Well TD 3580' 8" @ 214' Br. Lime 3261', KC 3274', TD 3580' 5" @ 3507' CO to 3472' 23/ 3346-52 FU 2150' oil S/ 25 boph Comp 25 bopd.	

COMPUTER

