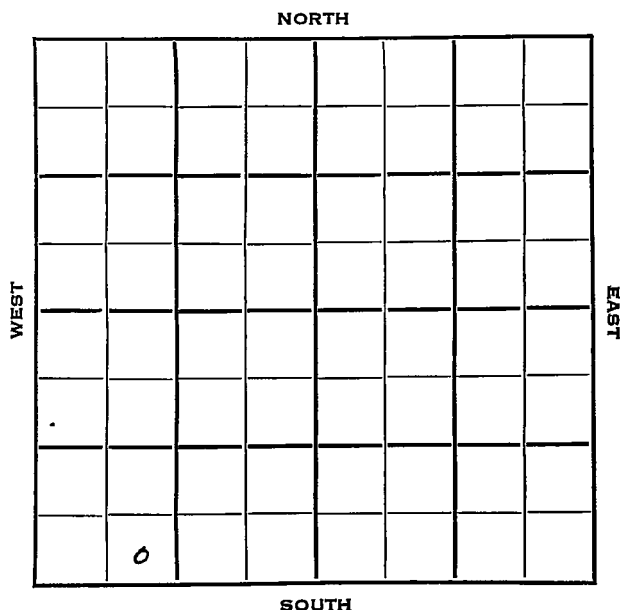


Section 4 Township 21 <sup>KANSAS</sup> Range 11WWell No. #1 Boyd "B"Company Harms & Knight

Stafford

KANSAS ✓

4

21

14W

Sec. \_\_\_\_\_ Twp. \_\_\_\_\_ R. \_\_\_\_\_

#1 Boyd "B"

Well No. \_\_\_\_\_ Farm \_\_\_\_\_

Harms &amp; Knight

Company \_\_\_\_\_

Harms &amp; Knight

Contractor \_\_\_\_\_

Wildcat

Ft. from N. Line

NORTH

330


Ft. from S. Line

Ft. from E. Line

990

Ft. from W. Line

SE SW SW

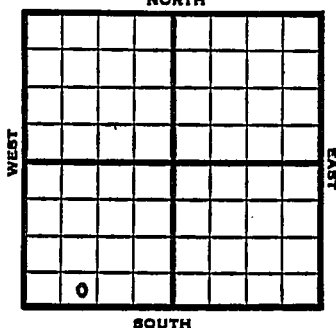

SOUTH

1953

Elev. 1927' REPORT


1/28 Spud 1-20-53  
 8" @ 853  
 Anhy 848  
 Drlg. 2471

2/4 Spud 1-20-53  
 D&A  
 TD 3665  
 8" @ 853  
 Anhy 848, Heeb 3202, Br Lime  
 3303, Lans 3314  
 DST 3553-76, opn  $\frac{1}{2}$  hrs., rec.  
 15' mud 11#  
 Arb. 3632  
 TD 3665  
 D&A

ABANDONED

**J. G. McGEHEE**

County Stafford State Kansas  
 Sec. 4 (Blk. 21) (Sur. 14W) Map No. 14W  
 Operator Harms & Knight  
 Well No. 1 Farm Boyd "B"  
 Elev. 1927 Location SE SW SW

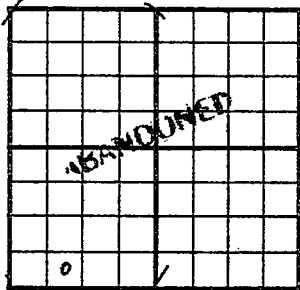

330 Ft. From S Line SW  
990 Ft. From W Line Quarter

1st. Report

Completion FEB 4 1953

Remarks Wildcat

Harms & Knight - Contr.

Spudding Date 1-20-53

Drlg. Data D & A TD 3665

8" @ 853 Anhy 848 Heeb. 3202

Br. lime 3303 Lans. 3314 DST 3553-76

open  $\frac{1}{2}$  hr. Rec. 15' mud 11# Arb. 3632

TD 3665

D & A

J. G. McGEHEE