

KANSAS

Section 4 Township 21 Range 14-WWell No. #1 LangerCompany Anschutz Drlg.

NORTH

							0

WEST

EAST

SOUTH

Stafford **KANSAS**

Sec. 4 Twp. 21 R. 14W ✓

Well No. #1 Langer Farm

Anschutz Drlg. Company

Wildcat


 Ft. from N. Line

330' Ft. from S. Line

330' Ft. from E. Line

 Ft. from W. Line

SE SE NE

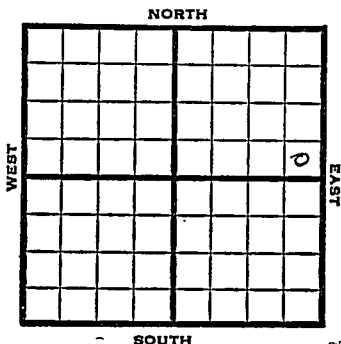

1950

Elev. 1920' REPORT

11/15

Location

12/27

Spud 11-18-50

Oil Well TD 3579

8" @ 342

Anhy 830 Heeb. 3183

Br Lime 3283 Lans. 3294

DST 3378-86 opn 1 hr

Rec. 60' wtr SO 3435-41


DST 3434-42 opn 35 min Rec. 145' ho

& gcm 5" @ 3576 500 A

S/25 boph Comp. 611 bopd

COMPLETED

J. E. TYRA

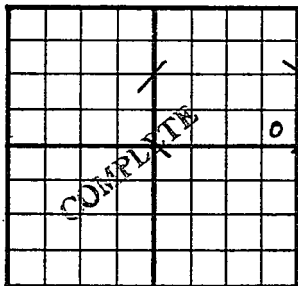County Stafford State KansasSec. 4 (Blk. 21) (Sur. 14W) (Rge. 14W) Map No.Operator Anschutz Drlg.Well No. 1 Farm LangerElev. 1920 Location SE SE NE

330 Ft. From S Line NE

330 Ft. From E Line Quarter

1st. Report

Completion DEC 27 1950Remarks WildcatSpudding Date 11-18-50Drlg. Data Oil well TD 35798" C 342 Anhy 830 Heeb. 3183Br. lire 3283 Lans. 3294 DST 3378-86open 1 hr. Rec. 60' water SO 3435-41DST 3434-42 open 35 min. Rec. 145' ho&gemCong. 3518 Sirp. 3529 Arb. 3575-79 TD5" C 3576 500 A S/ 25 bophComp. 611 bopd

J. E. TYRA