

Section 4 Township 21 Range 14WWell No. #1 BoydCompany Palmer Oil

NORTH

0							

WEST

EAST

SOUTH

Stafford **KANSAS**

Sec. 4 Twp. 21 R. 14W

Well No. #1 Boyd Farm

Palmer Oil Company

Wildcat Contractor


330' Ft. from N. Line

Ft. from S. Line

Ft. from E. Line

330' Ft. from W. Line

NW NW NW

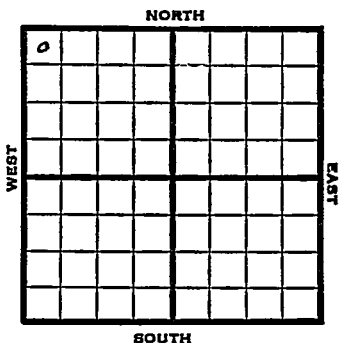

1951 Elev. 1915' REPORT

2/28 Spud 2-23-51
8-5/8" @ 842
Drlg. 2290'

4/4 Spud 2-23-51
Oil Well TD 3577
8-5/8" @ 842'
Heeb. 3184' KC 3294
DST 3416-68 opn 20 min
Rec. 810' g & ocm
Arb. 3572-77 TD 5" @ 3572
Comp. .1192 bopd 3% wtr

COMPLETED

County Stafford State KansasSec. 4 (Blk.) 21 (Sur.) 14W Map No.Operator Palmer OilWell No. 1 Farm BoydElev. 1915 Location NW NW NW

0							

FIRST REPORT

330 Ft. From N Line NW330 Ft. From W Line Quarter1st. Report FEB 28 1951


Completion

Remarks

Spudding Date 2-23-51Drlg. Data Wildcat8 5/8" @ 842 drlg. 2290

J. E. TYRA

County Stafford State Kansas
 Sec. 4 (Blk.) 21 (Sur.) 14W Map No.
 Operator Palmer Oil
 Well No. 1 Farm Boyd
 Elev. 1915 Location NW NW NW

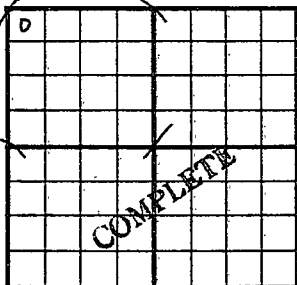

330 Ft. From N Line NW
 330 Ft. From W Line Quarter

1st. Report

Completion APR 4 1951

Remarks Wildcat

Spudding Date 2-23-51

Drilg. Data Oil well TD 3577

8 5/8" @ 842 Heeb. 3184 KC 3294

DST 3416-68 open 20 min. Rec. 810' g &

ocm Arb. 3572-77 TDT 5" @ 3572

Comp. 1192 bopd 3% water

J. E. TYRA