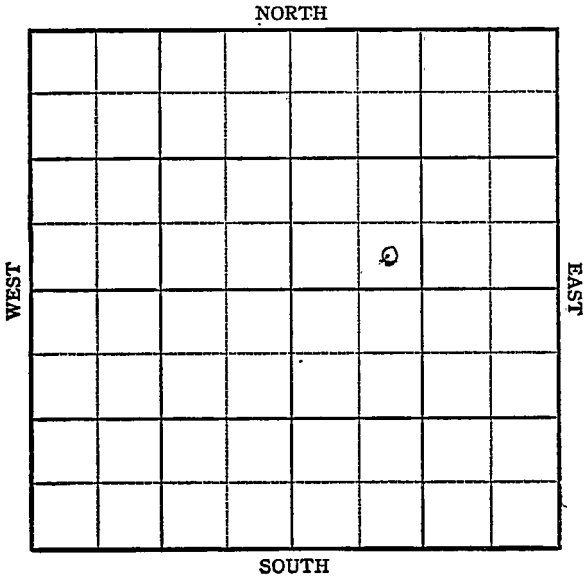


Section 4 Township 21 Range 7-WWell No. #3 EngellandCompany Petroleum Inc.
Wherry Pool

KANSAS

Rice

Sec. 4 Twp. 21 R. 7W ✓

Well No. #3 Engelland Farm

Petroleum, Inc. Company

Wherry Pool


 Ft. from N. Line

330' Ft. from S. Line

 Ft. from E. Line

990' Ft. from W. Line

SE SW NE

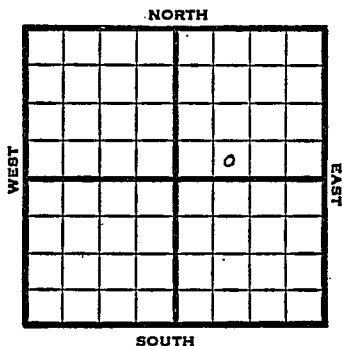

1948

Elev. 1617' REPORT

12/1

**8" @ 115'
Drlg. 1660'**

12/6

**Conglomerate 3356'
TD 3363'
5" @ 3356'**

12/14

2 qts CO

12/22

**Miss 3392'
TD 3400'**

ABANDONED

Map No. _____ Sec. 4 Twp. 21 R. 7W

Well No. 3 Engelland

Petroleum Inc. Company

FIRST REPORT Contractor

SE SW NE


SECTION PLAT

_____ Ft. from N. Line

330 Ft. from S. Line

_____ Ft. from E. Line

990 Ft. from W. Line

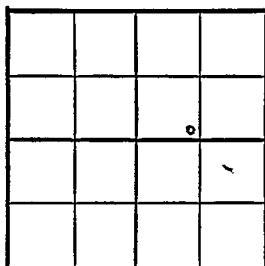

Rice County

RECORD

Location _____

Cased _____ in., _____ ft.

Rig up _____

Sand _____

Drilling and Remarks:

Gas _____

Oil _____

8" @ 115

Total Depth _____

drlg. 1660

PRODUCTION

1st 24 hrs. Nat. _____

1st 24 hrs. after shot _____

Gas _____ Cu. Ft.

Dry Hole _____

Abandoned _____

Date

DEC 1 1948 19

S. J. LEWIS Scout

Map No. 49 Sec. 4 Twp. 21 R. 7W

Well No. 3 Engelland

Petroleum Inc. _____ Company

ABANDONED

Contractor

SE SW NE

E11617
SECTION PLAT

_____ Ft. from N. Line

330 Ft. from S. Line

_____ Ft. from E. Line

990 Ft. from W. Line

		0	

Rice County

RECORD

Location _____

Cased _____ in., _____ ft.

Rig up _____

Sand _____

Drilling and Remarks:

Gas _____

Oil _____

Miss 3392

Total Depth 3400

PRODUCTION

1st 24 hrs. Nat. _____

1st 24 hrs. after shot _____

Gas _____ Cu. Ft.

Dry Hole _____

Abandoned _____

Date

DEC 22 1948

19

S. I. LEWIS

Scout