Form 51-5M 5-37 Petrol


Rice

KANSAS

Section 4 Township 21 Range 7-W

Well No. 1 Gossman

Company T. M. Deal

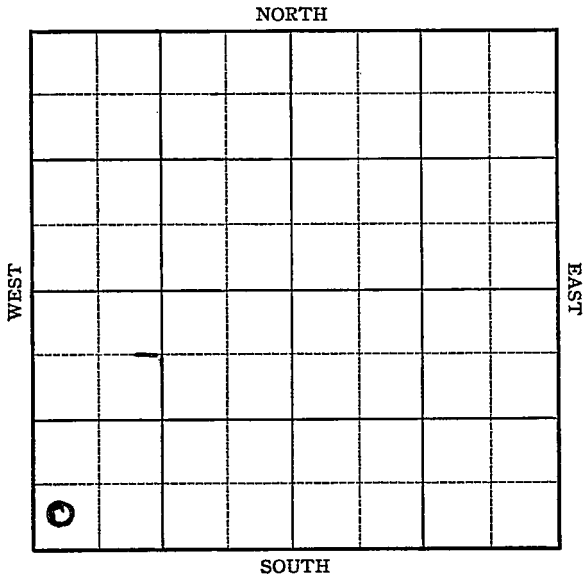

Form 252-A—5M—7-36—Palace **KANSAS** Rice

Sec. 4 Twp. 21 R. 7 W

Well No. #1 Gossman Farm

T. M. Deal Company


_____ Ft. from N. Line

330 Ft. from S. Line

_____ Ft. from E. Line

230 Ft. from W. Line

Elev. 1617

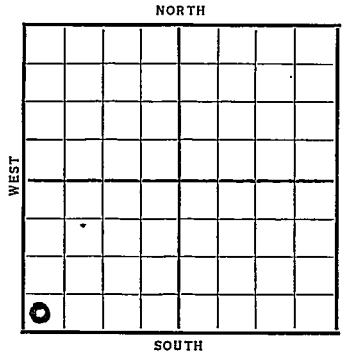

Date	REPORT
1937	
5/26	ROG.
6/4	13" @ 103'. WOC.
6/11	Drlg. 1650'.
6/19	Drlg. 2690'.
6/25	Cong. & 6" @ 3347'.
7/2	T.D. 3362'. H.F.O.
	Flowed 80 bbls. 30 min.
7/9	On potential.
7/14	5" liner 3356'.
	6" @ 3347'.
	Cong. 3347'.
	T.D. 3362'.
	Pot. 2230 bbls. flowing.
	COMPLETED

Form 26—1M Bks.—2-29 Rice KANSAS

Map No. _____ Sec. 4 Twp. 21 R. 7W


Well No. 1 – Gossman

T. M. Deal Company

_____ Contractor

FIRST REPORT

SECTION PLAT

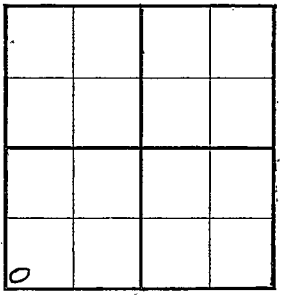

_____ Ft. from N. Line

330 Ft. from S. Line

_____ Ft. from E. Line

330 Ft. from W. Line

Location _____

Rig up _____

Drilling and Remarks:

Rig on gr.

RECORD

Cased _____ in., _____ ft.

Sand _____

Gas _____

Oil _____

Total Depth _____

PRODUCTION

1st 24 hrs. Nat. _____

1st 24 hrs. after shot _____

Gas _____ Cu. Ft.

Dry Hole _____

Abandoned _____

Date

MAY 26 1937 19

H. D. Hatfield Scout

Form 26—1M Bks.—2-29 Rice KANSAS

Map No. Sec. 4 Twp. 21 R. 7 W

Well No. 1 - Gossman

T. M Deal Company

Contractor

COMPLETED


Ft. from N. Line

330 Ft. from S. Line

Ft. from E. Line

230 Ft. from W. Line

SECTION PLAT

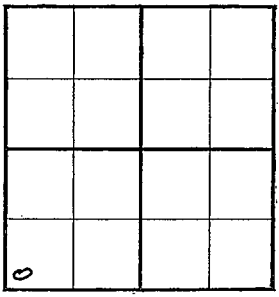

Location

Rig up

Drilling and Remarks:

PoT - 2230

Flowing

5" Liner - 3356

RECORD

Cased 6 in., 3347 ft.

~~Sand~~ Cong 3347

Gas

Oil

Total Depth 3362

PRODUCTION

1st 24 hrs. Nat.

1st 24 hrs. after shot

Gas Cu. Ft.

Dry Hole

Abandoned

Date

JUL 14 1937 19

H. D. Hatfield Scout