

Section 4 Township 21 Range 7WWell No. #1 TheedeCompany Geo. Seigrist

NORTH

WEST

EAST

						0	

SOUTH

Rice KANSAS

SEC. 4	TWP. 21	R. 7 W
---------------	----------------	---------------

WELL NO.

1 Theede

FARM

COMPANY

Geo. Seigrist

CONTRACTOR

Stearns

Wherry


_____ Ft. from N. Line

_____ Ft. from S. Line

_____ Ft. from E. Line

_____ Ft. from W. Line

SW SE SE

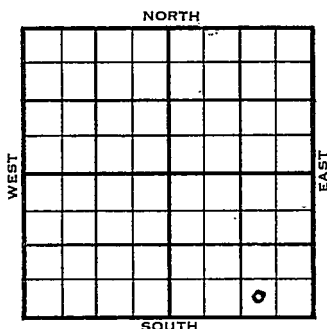

1955

ELEVATION

1611'

REPORT

5/25

Spud 4-30-55 8" ?
 TD 3339' 5" @ 3338' DD 3351'
 B/1/2 GOPH frac. S/3 BOPH
 30% wtr. 8 hr.
 Comp. 25 BOPD 30% wtr.
 KC Lansing 2899', Congl. 3318'
 TD 3351'

FIRST REPORT
 ↓
COMPLETED

FIRST REPORT COMPLETED

FORM 513 REV. SUNRAY

County Rice Elev. 1611
 Sec. 4 Twp. 21 Rge. 7W
 Company Geo. Seigrist
 Farm Name Theede No. 1

TOPS	DEPTH	DATUM
Cim. Anhydrite		
Fl. Riley		
Howard		
Topeka		
Heebner Sh.		
Toronto Ls.		
Brown Lime		
Lansing <u>KC</u>	<u>2899</u>	<u>1288</u>
Kans. City		
B. K. C.		
Congl.	<u>3318</u>	<u>1707</u>
Miss.		
Kinderhook		
Misener		
Hunton		
Sylv. Maquo		
Viola		
Simpson		
Smp.		
Gorham		
Arbuckle		
Basal Sand		
Pre. Cam.		
T. D.	<u>3351</u>	

Loc. in Section SW SE SE

Drig. Contr. Stearns

Pool Wherry

Date Comm. MAY 25 '55

Date Comp. MAY 25 '55

Spud 4-30-55 8" TD 3339 5" @ 3338

DD 3351 B/ $\frac{1}{2}$ goph. frac S/ 3 boph
 30% wtr. 8 hr. Comp. 25 bopd 30% wtr