


KANSAS

Rice

Section 4 Township 21 Range 7WWell No. 3 GossmanCompany MagnoliaWherry

NORTH

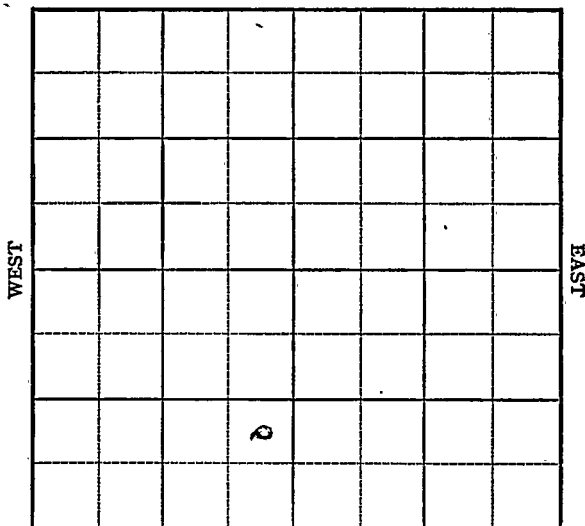

SOUTH

KANSAS

Rice

Sec. 4 Twp. 21 R. 7W ✓

Well No. #3 Gossman Farm
Magnolia Company

Wherry Pool

 Ft. from N. Line

990'


 Ft. from S. Line

330'

 Ft. from E. Line

 Ft. from W. Line

NE SE SW

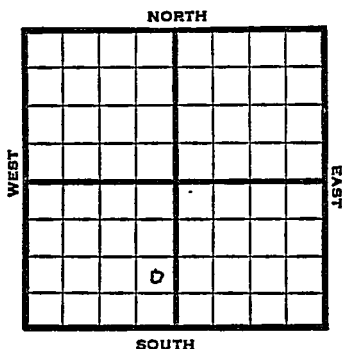

1949

Elev 1614' REPORT

2/23

RUR

3/2

10" @ 202'

Drlg. 1880'

3/8

Drlg 3235'

3/16

~~Miss 3374'~~

Viola 3670'

Arbuckle 3765'

Drlg. 3777'

3/22

TD 3800'

6" @ 3450'

75 shots 3374-87

SO&W

3/30

"

4/6

TD 3800'

Arb. 3765'

6" @ 3450'

Miss 3402' (Corrected)

Aband.

ABANDONED

Map No. _____ Sec. 4 Twp. 21 R. 7W

Well No. 3 Gossman

Magnolia Company

FIRST REPORT Contractor

NE SE SW


SECTION PLAT

_____ Ft. from N. Line

990 Ft. from S. Line

330 Ft. from E. Line

_____ Ft. from W. Line

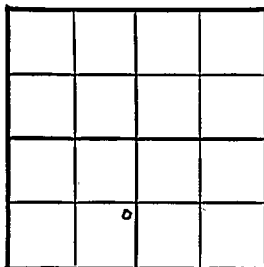

Rice County

Location _____

Rig up _____

Drilling and Remarks:

R U R

RECORD

Cased _____ in., _____ ft.

Sand _____

Gas _____

Oil _____

Total Depth _____

PRODUCTION

1st 24 hrs. Nat. _____

1st 24 hrs. after shot _____

Gas _____ Cu. Ft.

Dry Hole _____

Abandoned _____

Date

FEB 23 1949

S. J. LEWIS Scout

Map No. 49 Sec. 4 Twp. 21 R. 7W

Well No. 3 Gossman

Magnolia Company

ABANDONED

Contractor

NE SE SW

E1.1614

SECTION PLAT

 Ft. from N. Line

990 Ft. from S. Line

330 Ft. from E. Line

 Ft. from W. Line

Rice County

Location

Rig up

Drilling and Remarks:

Cor 8765

6" 03458

Mine 0402 corrected

RECORD

Cased in., ft.

Sand

Gas

Oil

Total Depth 3800

PRODUCTION

1st 24 hrs. Nat.

1st 24 hrs. after shot

Gas Cu. Ft.

Dry Hole

Abandoned

Date

APR 6 1949 19 S. J. LEWIS Scout