


KANSAS Rice

Section 4 Township 21 Range 7W

Well No. 1 Bossman Est. (Grossman)

Company Magnolia

Wherry Pool
NORTH

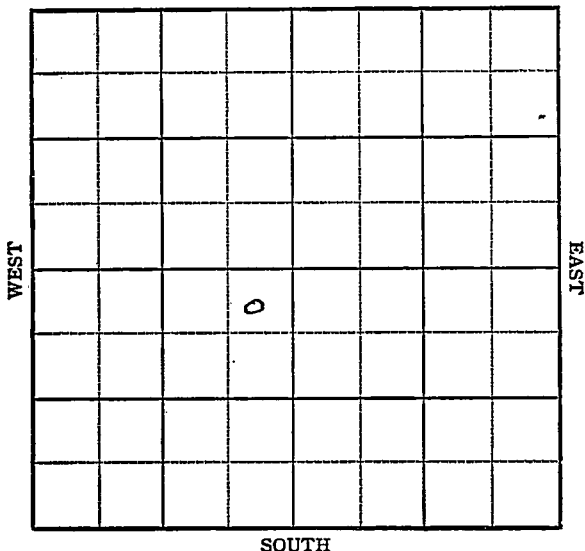

KANSAS

Rice

7W



Sec. 4 Twp. 21 R. 7W


Well No. #1 Bossman Est. Farm

Magnolia

Company

Wherry Pool

NORTH

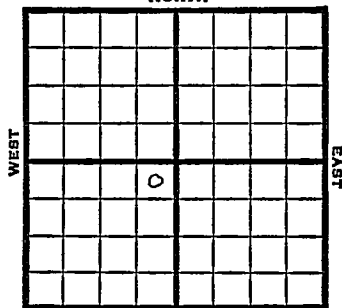

SOUTH

330' Ft. from N. Line

Ft. from S. Line

330' Ft. from E. Line

Ft. from W. Line

NE SW

1948

Elev 1615'

REPORT

12/15 8" @ 220'

12/22 Drlg. 3005'

12/29 Conglomerate 3339'

TD 3346'

5" @ 3341'

1949

1/12

TD 3350'

Cong 3339'

5" @ 3341'

Pump 60 Oil Pot

40⁹ Gr.

Comp

COMPLETED

Map No. _____ Sec. 4 Twp. 21 R. 7W

Well No. 1 Bossman Est.

Magnolia Company

FIRST REPORT

Contractor

NE SW


SECTION PLAT

330 Ft. from N. Line

_____ Ft. from S. Line

330 Ft. from E. Line

_____ Ft. from W. Line

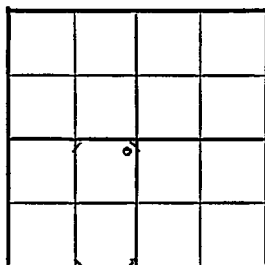

Rice County

Location _____

Rig up _____

Drilling and Remarks:

8" @ 220

RECORD

Cased _____ in., _____ ft.

Sand _____

Gas _____

Oil _____

Total Depth _____

PRODUCTION

1st 24 hrs. Nat. _____

1st 24 hrs. after shot _____

Gas _____ Cu. Ft.

Dry Hole _____

Abandoned _____

Date

DEC 15 1948

19

S. J. LEWIS

Scout

Map No. 49 Sec. 4 Twp. 21 R. 7W

Well No. 1 Bossman Est.

Magnolia

Company

COMPLETE

Contractor

NE SW


E. 16 15
SECTION PLAT

330 Ft. from N. Line

Ft. from S. Line

330 Ft. from E. Line

Ft. from W. Line

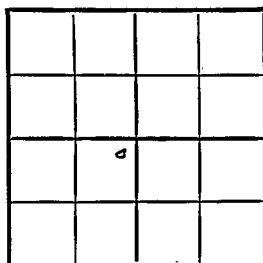

Rice County

RECORD

Location

Cased _____ in. _____ ft.

Rig up

Sand

Drilling and Remarks:

Gas

Oil ☒

Total Depth 3350

Cong 3339

5" 3341

Pump 60 oil

PRODUCTION

1st 24 hrs. Nat. _____

1st 24 hrs. after shot _____

Gas _____ Cu. Ft.

Dry Hole _____

Abandoned _____

HD 3 1/2

Date

JAN 12 1949

19

S. J. LEWIS

Scout