


Company Magnolia

Wherry Pool
NORTH

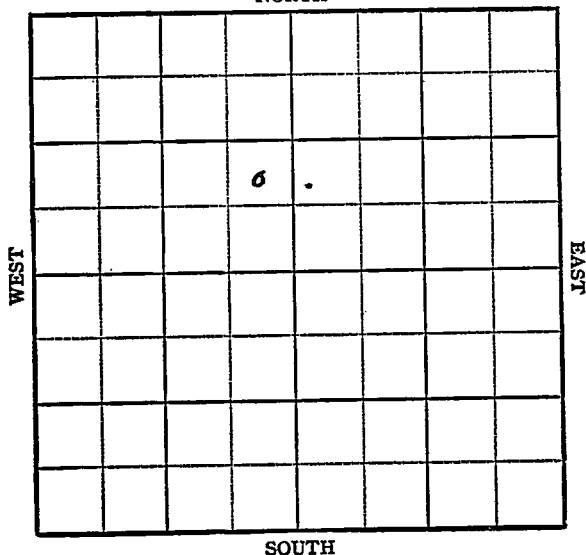

KANSAS

Rice

Sec. 4 Twp. 21 R. 7W ✓

Well No. #2 K. Willhauf Farm

Magnolia

Company

Wherry Pool

 Ft. from N. Line

990'


 Ft. from S. Line

330'

 Ft. from E. Line

 Ft. from W. Line

NE SE NW

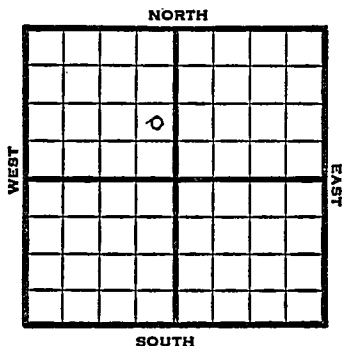

1948

Elev. 1619' REPORT

12/29

RUR

1/5

8" @ 208'

Drlg. 1695'

1/12

Drlg 3180

1/19

Cong 3352-54'

TD 3354'

5"@ 3351

Flow 21 bbls oil PH 5 hrs.

1/26

Cong. 3352'

5" @ 3351'

Pump 60 oil Pot.

Gr. 39°

TD 3354'

COMPLETED

Map No. _____ Sec. 4 Twp. 21 R. 7W

Well No. 2 K. Willhauf

Magnolia Company

FIRST REPORT

Contractor _____

NE SE NW

SECTION PLAT

		o	

_____ Ft. from N. Line

990 Ft. from S. Line

330 Ft. from E. Line

_____ Ft. from W. Line

Rice County

Location _____

Rig up _____

Drilling and Remarks:

R U R

RECORD

Cased _____ in., _____ ft.

Sand _____

Gas _____

Oil _____

Total Depth _____

PRODUCTION

1st 24 hrs. Nat. _____

1st 24 hrs. after shot _____

Gas _____ Cu. Ft.

Dry Hole _____

Abandoned _____

Date

DEC 29 1948 19 S. J. LEWIS Scout

Kansas

Map No. 49 Sec. 4 Twp. 21 R. 7WWell No. 2 K. Willhauf

Magnolia

Company

COMPLETE

Contractor


NE SE NW

E11619
SECTION PLAT

_____ Ft. from N. Line

990 Ft. from S. Line330 Ft. from E. Line

_____ Ft. from W. Line

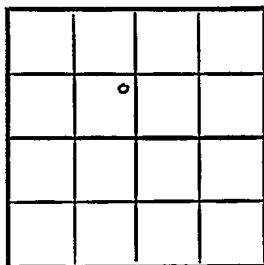

Rice County

Location _____

Rig up _____

Drilling and Remarks:

*Cong 8252**5' @ 8251**Pump 60 oil 1st**39° 1/2*

RECORD

Cased _____ in., _____ ft.

Sand _____

Gas _____

Oil ☒Total Depth 8254

PRODUCTION

1st 24 hrs. Nat. _____

1st 24 hrs. after shot _____

Gas _____ Cu. Ft.

Dry Hole _____

Abandoned _____

Date

JAN 26 1949 19

S. J. LEWIS Scout