


Map No. **KANSAS** Sec. 4 Twp. 21 R. 10^wWell No. 1 Gibson FarmGypsy Oil Company

NORTH

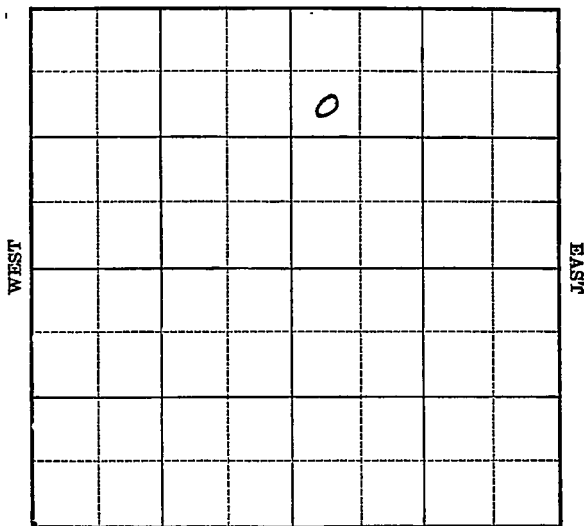

SOUTH

Location _____

Drilling Remarks _____

RECORD

Cased _____ in. _____ ft.

Sand _____

Gas _____

Oil _____

Total Depth _____

Rig Up _____

Drilling Remarks _____

PRODUCTION

1st 24 hrs. Nat. _____

1st 24 hrs. after shot _____

Gas _____ cu. ft.

Dry Hole _____

Abandoned _____

Rice

Map No. KANSAS Sec. 4 Twp. 21 R. 10^W

Well No. 1 Gibson Farm


Gypsy Oil Company

990 Ft. from N. Line

 Ft. from S. Line

 Ft. from E. Line

393 Ft. from W. Line

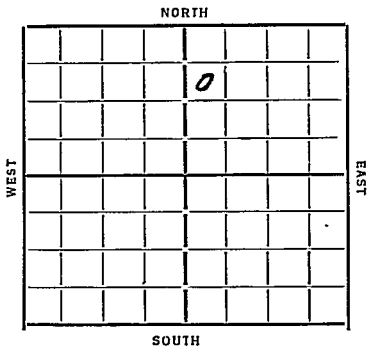

Date 7/25

REPORT

7/25 B.R.
8/1 Rgn up
8/9 dly 1392 8" 112
8/16 " 2145
8/23 " 2669
8/30 " 3189
9/6 B.K.C. 3273 Simpson 3300
T Sil 3361 3368 1/2 S D
9/13 PB 3322 Cement 5" 3300
9/19 Silicious 3361 T D 3368 1/2
D r A

ABANDONED

Map No. 46 Sec. 4 Twp. 31 R. 10WWell No. 1—GibsonGypsy Oil Company

Contractor

FIRST REPORTS990 Ft. from N. Line

_____ Ft. from S. Line

_____ Ft. from E. Line

39.3 Ft. from W. Line**SECTION PLAT**

		0	

Location _____

Rig up _____

Drilling and Remarks:

BR

RECORD

Cased _____ in., _____ ft.

Sand _____

Gas _____

Oil _____

Total Depth _____

PRODUCTION

1st 24 hrs. Nat. _____

1st 24 hrs. after shot _____

Gas _____ Cu. Ft.

Dry Hole _____

Abandoned _____

Date

7-25-34 19Scout
ORVAL MANNSCHRECK

Map No. 46 Sec. 4 Twp. 21 R. 10W

Well No. 1-Sibson

Crude oil Company

Contractor

ABANDONED SECTION PLAT

990 Ft. from N. Line

..... Ft. from S. Line

..... Ft. from E. Line

393 Ft. from W. Line

		0	

Location.....

Rig up.....

Drilling and Remarks:

Not A

RECORD

Cased _____ in., _____ ft.

Sand Siliceous 3361

Gas.....

Oil.....

Total Depth 3368 1/2

PRODUCTION

1st 24 hrs. Nat.....

1st 24 hrs. after shot.....

Gas..... Cu. Ft.

Dry Hole.....

Abandoned.....

Date

ORVAL MANNSCHRECK

9-19-34 192

Scout