


Section 4 Township 21 Range 12-W

Well No. #1 DeWerff

Company Texas

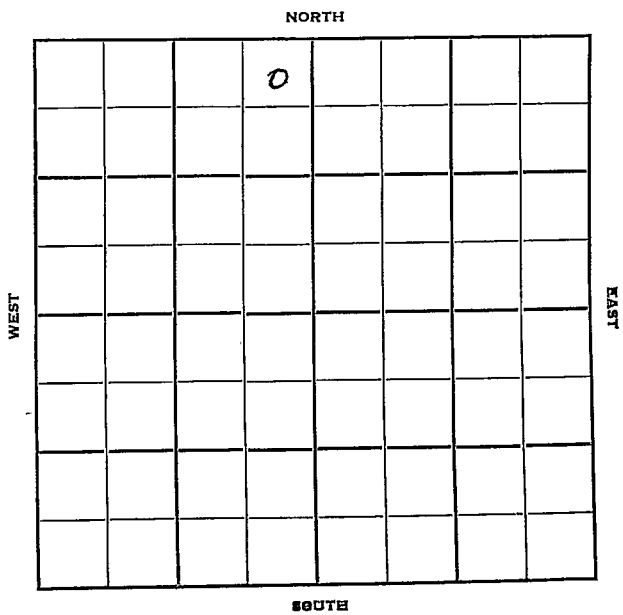

Sec. 4 Twp. 21 R. 12W

Well No. #1 DeWerff Farm

Texas Company


Contractor

330' Ft. from N. Line

_____ Ft. from S. Line

330' Ft. from E. Line

_____ Ft. from W. Line

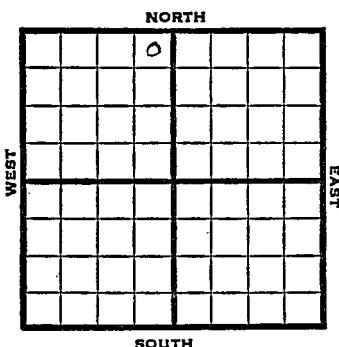

NE NE NW

1950

Elev 1842' REPORT

2/22

Spud 2-20-50
10-3/4" @ 635'

WOC

3/22

10 3/4" @ 635'
Br Lime 3149'
Lans 3168'
DST 3324-31
Rec 90' oil cut mud
Cong 3397'
Arb. 3434-37' TD
TD 3437'
7"@ 3433'
Comp 354 BOPD
Comp

COMPLETED

Map No. _____ Sec. 4 Twp. 21 R. 12WWell No. 1 DeWerffTexas

Company _____

Contractor _____

NE NE NW

330 Ft. from N. Line

_____ Ft. from S. Line

330 Ft. from E. Line

_____ Ft. from W. Line

SECTION PLAT

| | | | |
|--|---|--|--|
| | o | | |
| | | | |
| | | | |
| | | | |

FIRST REPORT

Stafford County

Location _____

Rig up _____

Drilling and Remarks:

Spud 2-20-50

10 3/4" @ 635

WOC

RECORD

Cased _____ in., _____ ft.

Sand _____

Gas _____

Oil _____

Total Depth _____

PRODUCTION

1st 24 hrs. Nat. _____

1st 24 hrs. after shot _____

Gas _____ Cu. Ft.

Dry Hole _____

Abandoned _____

Date

FEB 22 1950

19

J. E. TYRA

Scout

Kansas

Map No. _____ Sec. 4 Twp. 21 R. 12W

Well No. 1 DeWerff

_____ Texas _____ Company

_____ Contractor

NE NE NW

E 1. 1842

SECTION PLAT

330 Ft. from N. Line

_____ Ft. from S. Line

330 Ft. from E. Line

_____ Ft. from W. Line

| | | | |
|--|--|----------|--|
| | | o | |
| | | COMPLETE | |
| | | | |
| | | | |

Stafford County

Location _____

Rig up _____

Drilling and Remarks:

10 3/4' @ 635
Br line 3149
Lans. 3168
DST 3324-31
Rec. 90' oil cut mud
Comp. 3397
arb. 3434-37 T.D.
7" @ 3433

Comp. 354 bopd
 Date _____

RECORD

Cased _____ in., _____ ft.

Sand _____

Gas _____

Oil _____

Total Depth _____

PRODUCTION

1st 24 hrs. Nat. _____

1st 24 hrs. after shot _____

Gas _____ Cu. Ft.

Dry Hole _____

Abandoned _____

MAR 22 1950 19

J. E. TYRA

Scout