

Section 4 Township 21 Range 12WWell No. #2 DeWerffCompany Texas

NORTH

		0					

WEST

EAST

SOUTH

Stafford KANSAS

Sec. 4 Twp. 21 R. 12W

Well No. #2 DeWerff Farm

Texas Company

Anschutz Drlg. - Contr. Contractor

Bryant Pool


330' Ft. from N. Line

 Ft. from S. Line

990' Ft. from E. Line

 Ft. from W. Line

NW NE NW

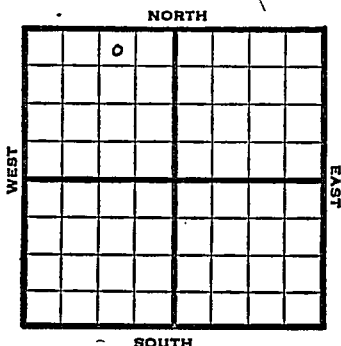

1950

Elev 1840'

REPORT

11/22

RUR

12/13

Arb 3406-11

7" @ 3408

TD 3429

FU 500' oil 6 hr

500 A

S/42 bo 8 hr

DD 3436

S/5 $\frac{1}{2}$ boph

Comp 151 bopd

Completed TD 3436'

COMPLETED

County Stafford State KansasSec. 4 (Blk. Twp.) 21 (Sur. Rge.) 12W Map No.Operator TexasWell No. 2 Farm DeWerffElev. Location NW NE NW

		0				

330 Ft. From N Line NW990 Ft. From E Line Quarter1st. Report NOV 22 1950

Completion

Remarks

Anschutz Drlg. - Contr.

Spudding Date

Drlg. Data Bryant PoolR U R

J. E. TYRA

County Stafford State KansasSec. 4 (Blk.
Twp.) 21 (Sur.
Rge.) 12W Map No.Operator TexasWell No. 2 Farm DeWerffElev. 1840 Location NW NE NW

330 Ft. From N Line NW990 Ft. From E Line Quarter

1st. Report

Completion DEC 13 1978Remarks Bryant PoolAnschutz Drlg. - Contr.

Spudding Date

Drlg. Data Oil well TD 3436Arb. 3406-11 7" @ 3408 TD 3429FU 500' oil 6 hr. 500 A S/ 42 bo 8 hrDD 3436 S/ 5½ bophr Comp. 151 bopd