


Section 4 Township 21 Range 12W

Well No. #4 DeWerff

Company Texas Company

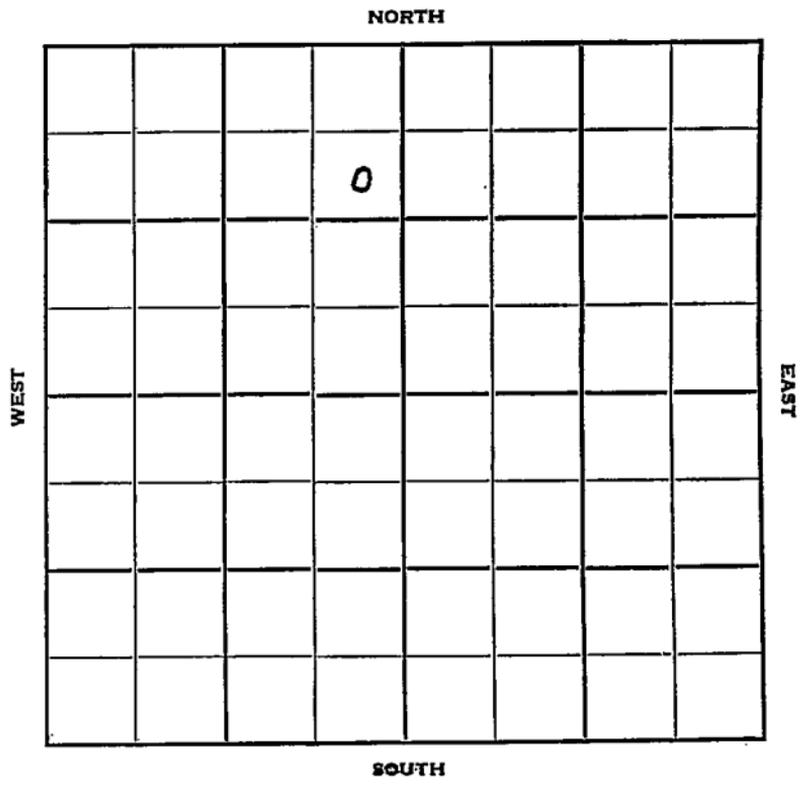

Sec. 4 Twp. 21 R. 12W

Well No. #4 DeWerff Farm

Texas Company Company

Contractor


990 Ft. from N. Line

Ft. from S. Line

330 Ft. from E. Line

Ft. from W. Line

SE NE NW

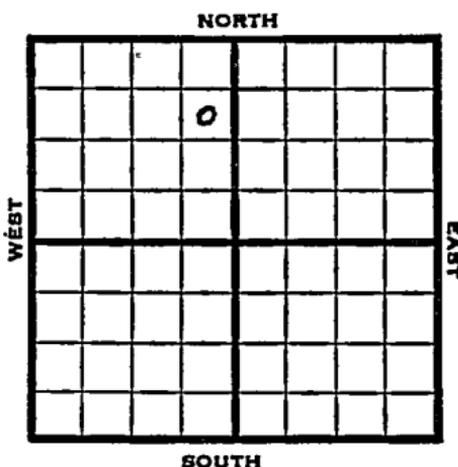

1952 Elev. 1836 REPORT

11/19 MIM.

11/27 Drlg.

12/4 Heeb 3023, Br li 3152, Lans 3167
Arb. 3406

12/11 RTD 3511 7" @ 3510

12/18 DD 3516 FU 1330' wtr 2 Hrs. S/12 BWPH
PB 3508 24/3500-3506 Dry 28/3472-80
PB/3492 500A 3472-80 S/32 GW #4 GO

12/25 " " " "

1/1 TESTING

1/8 TESTING

1/22 "

1/29 "

2/5 "

2/11 Spudding date 11/18/52

SWD well TD 3511

10" @ 629 DST 3204-12 open 1 hr.

Rec. 180' hocom 120' ho & Gcsw 230'

sw 965# Heeb. 3023 Br. Lime 3152

Lans. 3167 DST 3227-43 open 1 hr.

rec. 50' so & gcm 610# DST 3286-

OVER

1953

2/11

(cont.) DST 3320 open 1 hr. Rec. 90' o & gcm 30' wtr. 695# DST 3327-40 open 1 hr. gas in er mi rec. 30' o & gcm 330# Arb. 3406 TD 3511 7" @ 3510 DD 3516 FU 1330' wtr. 2 hr. S/12 bwph PB 3508 24/3500-66 dry 28/3472-80 PB 3493 500 A S/132 gw 4 go PB 3470 24/3462-67 5 go 110 gw PB 3453 16/3442-46 500 A S/5 bwph 3 hr. PB 3436 24/3425-31 2 go 3 gw 3 hr. 500 A S/7 bwph & S0 CO to 3425 28/3414 -21 5 gwph & SSO 500A S/30 Go 17 gw 5 hr. s/12 bo 12 bw PB 3422 S/25 go 20 gwph 14 hr. 1500A 29 go 130 gwph PB 3353 32/3328-36 1½ gwph 250 A S/62 bo S/.116 bo 28 bw 24 hr. PB 3318 32/3293-3301 3 gwph & SSO 250 A S/29 bo 117 bw 19 hr. 20/3258-62 20/3265-71 dry 250 A S/2½ bwph CO to 3354 48/3324-36 750 5 go 20 gwph 2500 A 7 go 42 gwph PB 3248 40/3230-40 5 gwph & SSO 250A s/2½ bo 27 bwph 5 bo 32 bwph CO to 3353 14 go 31 gwph 2 hr. 32/3332-40 2 gwph 2000 A S/42 bw 5 hr. 1000A S/27 bf 1 hr. PB 3317 24/3294-3300 13 gw 2000 A S/3 bo 17 bwph 5 hr. PB 3223 1t/3216-20 500 A S/4 bfph 97% wtr. PB 3201 12/3170-73 20/3176-81 3 gwph 500 A S/4 bfph 8% oil Comp. for SWD well.

ABANDONED

Scout Cards	_____
Land Small Map	_____
Land Walk Map	_____
Tracings	_____
France Map	_____
Pierce Map	_____
Misc.	_____

CD

NOV 21 1952

Drlg. Data

500 A S/ 7 bwph & SO CO to 3425.
28/ 3414-21 5 gwph & SSo 500 A S/ 30 go
17 gw 5 hr. S/ 12 bo 12 bw PB 3422
S/ 25 go 20 gwph 14 hr. 1500A 29 go
130 gwph PB 3353 32/ 3328-36 1½ gwph
250 A S/ 62 bo S/ 116 bo 28 bw 24 hr.
PB 3318 32/ 3293-3301 3 gwph & SSo 250 A
S/ 29 bo 117 bw 19 hr. 20/ 3258-62
20/ 3265-71 dry 250 A S/ 2½ bwph
CO to 3354 48/ 3324-36 750 A 5 go 20 gw
ph 2500 A 7 go 42 gwph PB 3248
40/ 3230-40 5 gwph & SSo 250 A
S/ 2½ bo 27 bwph 5 bo 32 bwph CO to
3353 14 go 31 gwph 2 hr. 32/ 3332-40
2 gwph 2000 A S/ 42 bw 5 hr. 1000 A
S/ 27 bf 1 hr. PB 3317 24/ 3294-3300
13 gw 2000 A S/ 3 bo 17 bwph 5 hr.
PB 3223 16/ 3216-20 500 A S/ 4 bfph
97% wtr. PB 3201 12/ 3170-73 20/ 3176-81
3 gwph 500 A S/ 4 bfph 8% oil

Comp. for SWB well

Land Small Map.....

Land Wall Map.....

Tracings.....

France Map.....

Pierce Map.....

Misc.....

FEB 18 1953