


**KANSAS** Stafford

Section 4 Township 21 Range 12W

Well No. 1 Seacil

Company Hinkle Oil

Workman  
NORTH

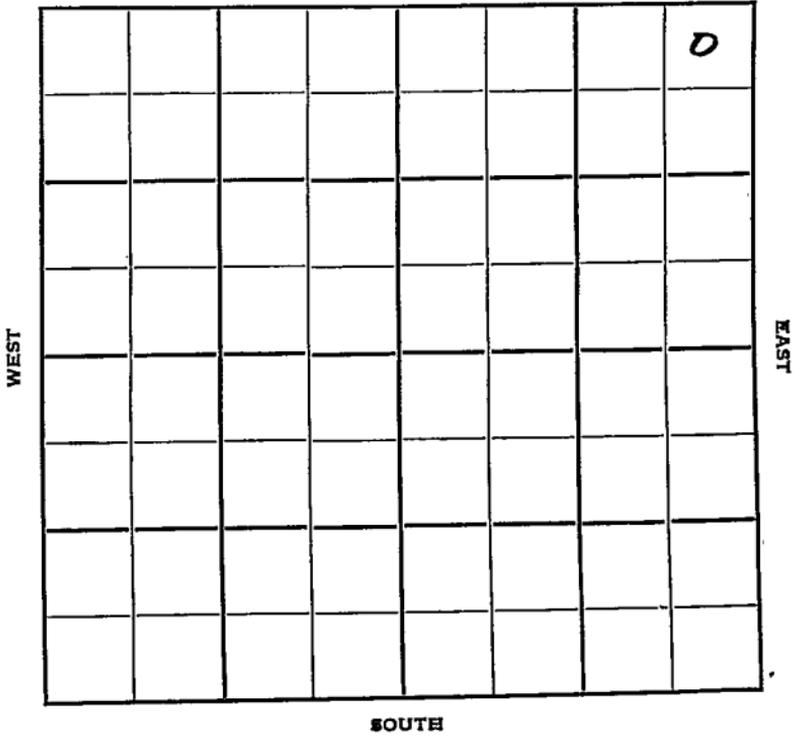

Sec. 4 Twp. 21 R. 12W ✓

Well No. #1 Saacil Farm

Hinkle Oil Company

Workman Pool


330' Ft. from N. Line

\_\_\_\_\_ Ft. from S. Line

330' Ft. from E. Line

\_\_\_\_\_ Ft. from W. Line

NE/C

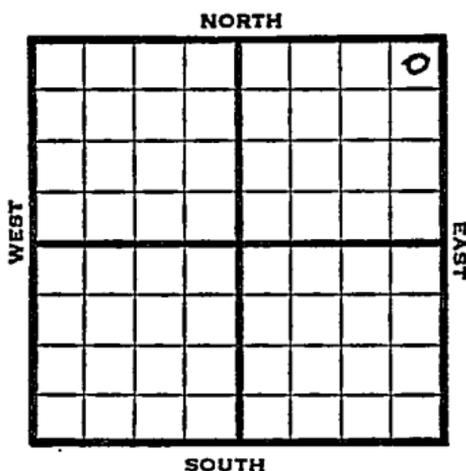

1949 Elev 1850' REPORT

4/13 RUR

4/20 8" @ 214'  
Drig. 2235'

4/27 Lans. 3181'  
Arb. 3412-24'  
TD 3424'  
5" @ 3417'

5/4 "

5/10 "

5/18 "

5/25 "

6/1 "

6/7 Pump 40 bbls oil a day

6/15 Arb. 3412'  
5" @ 3417'

TD 3424'

Pump 453 Oil Pot

41° Gr.

Comp

**COMPLETED**

Map No. \_\_\_\_\_ Sec. 4 Twp. 21 R. 12W

Well No. 1 Seacil

Hinkle Oil Company

### FIRST REPORT

Contractor \_\_\_\_\_

NE/C


#### SECTION PLAT

330 Ft. from N. Line

\_\_\_\_\_ Ft. from S. Line

330 Ft. from E. Line

\_\_\_\_\_ Ft. from W. Line

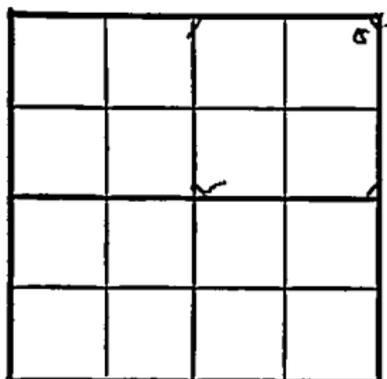

Stafford County

Location \_\_\_\_\_

Rig up \_\_\_\_\_

Drilling and Remarks:

R U R

#### RECORD

Cased \_\_\_\_\_ in., \_\_\_\_\_ ft.

Sand \_\_\_\_\_

Gas \_\_\_\_\_

Oil \_\_\_\_\_

Total Depth \_\_\_\_\_

#### PRODUCTION

1st 24 hrs. Nat. \_\_\_\_\_

1st 24 hrs. after shot \_\_\_\_\_

Gas \_\_\_\_\_ Cu. Ft.

Dry Hole \_\_\_\_\_

Abandoned \_\_\_\_\_

Date

APR 13 1949

19

S. I. LEWIS

Scout

Stafford County Kansas State

Map No. K 46 Sec. 4 Twp. 21 R. 12W

Well No. 1 Seacil

Hinkle Oil Company

COMPLETE

Contractor

NE/C

E. 1738  
SECTION PLAT

330 Ft. from N. Line

       Ft. from S. Line

330 Ft. from E. Line

       Ft. from W. Line

							0

Workman Pool

Remarks:

*Per 43412*

*5" 43417*

*7113424*

*Per 453 oil Prod*

*410/32*

Date

Scout

JUN 15 1949