

Section 4 Township 21 Range 12W

Well No. #4 Space 1

Company Yarnell & Parrish

NORTH

					0		

WEST

EAST

SOUTH

Sec. 4 Twp. 21 R. 12W

Well No. #4 Spacel Farm

Yarnell & Parrish Company

Workman SE Contractor


330' Ft. from N. Line

_____ Ft. from S. Line

_____ Ft. from E. Line

990' Ft. from W. Line

NE NW NE

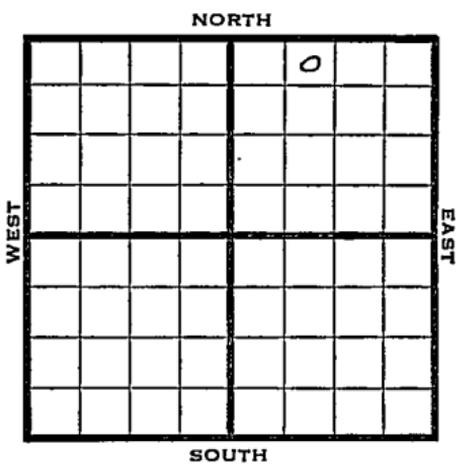

1950

Elev 1838

REPORT

4/19

Spud 4-13-50
8" @ 275'
Drilg. 500'

5/24

8" @ 275'
Lans 3178
Arb 3420-27
5" @ 3424
TD 3435
FU 200' oil
Comp 297 bopd
Completed

COMPLETED

Map No. _____ Sec. 4 Twp. 21 R. 12WWell No. 4 SpacelYarnell & Parrish Company

Contractor

NE NW NE

330 Ft. from N. Line

_____ Ft. from S. Line

_____ Ft. from E. Line

990 Ft. from W. Line

SECTION PLAT

		0	

FIRST REPORT

Stafford County

Location _____

Rig up _____

Drilling and Remarks:

Spud 4-13-50

8" @ 275

drlg. 500

RECORD

Cased _____ in., _____ ft.

Sand _____

Gas _____

Oil _____

Total Depth _____

PRODUCTION

1st 24 hrs. Nat. _____

1st 24 hrs. after shot _____

Gas _____ Cu. Ft.

Dry Hole _____

Abandoned _____

Date

APR 19 1950 19

J. E. TYRA Scout

Kansas

Map No. _____ Sec. 4 Twp. 21 R. 12WWell No. 4 SpacelYarnell & Parrish Company

Contractor

NE NW NE

E1.1838
SECTION PLAT330 Ft. from N. Line

_____ Ft. from S. Line

_____ Ft. from E. Line

990 Ft. from W. Line

		0	
COMPLETE			

Stafford

Location _____

Rig up _____

Drilling and Remarks:

8" c 275
 Lane. 3178
 arb. 3420 - 27
 5" c 3424
 T.D. 3435
 74. 200' oil
 Comp. 297 bopd

Date

RECORD

Cased _____ in., _____ ft.

Sand _____

Gas _____

Oil _____

Total Depth _____

PRODUCTION

1st 24 hrs. Nat. _____

1st 24 hrs. after shot _____

Gas _____ Cu. Ft. #

Dry Hole _____

Abandoned _____

MAY 24 1950

19

J. E. TYRA Scout