
FORM 51 25M 3-49 PETROL

Stafford **KANSAS**

Section 5 Township 21 Range 13W

Well No. #1 Newcomb

Company Wewtgate-Greenland

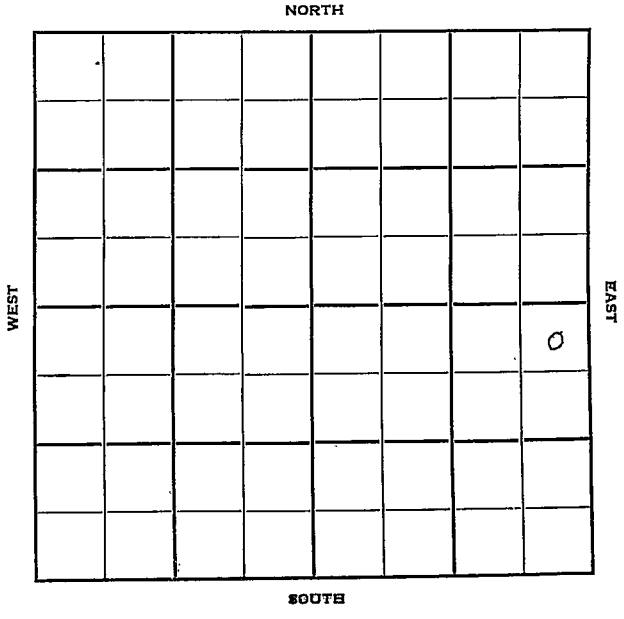

FORM 252-B
10M 9-49 PETROL

Stafford KANSAS

Sec. 5 Twp. 21 R. 13W

Well No. #1 Newcomb Farm

Westgate-Greenland Company

Contractor

Wildcat


330' Ft. from N. Line

Ft. from S. Line

330' Ft. from E. Line

Ft. from W. Line

NE NE SE

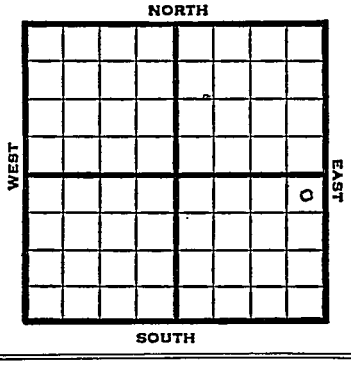

1950	REPORT
	Elev 1898'
1/25	Location
2/8	TD 3782'
	9 5/8" @ 300'
	Heeb 3186'
	Br L 3306'
	Lans 3318'
	BKC 3538'
	Cong 3558'
	Arb. 3753'
	D&A
	Aband.

ABANDONED

Form 26 200 Bks. 6-49 Petrol

Kansas

Wildcat

Map No. _____ Sec. 5 Twp. 21 R. 13W

Well No. 1 Newcomb

Westgate-Greemland Company

Contractor

NE NE SE

330 Ft. from N. Line


Ft. from S. Line

330 Ft. from E. Line

Ft. from W. Line

Stafford County

SECTION PLAT

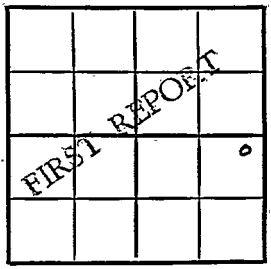

Location X

Rig up

Drilling and Remarks:

RECORD

Cased _____ in., _____ ft.

Sand

Gas

Oil

Total Depth

PRODUCTION

1st 24 hrs. Nat.

1st 24 hrs. after shot

Gas _____ Cu. Ft.

Dry Hole

Abandoned

Date

JAN 25 1950 19

J. E. TYRA Scout

Form 26 200 Bks. 11-49 Petrol

Kansas Wildcat

Map No. ____ Sec. 5 Twp. 21 R. 13W

Well No. 1 Newcomb

Westgate-Greenland Company

Contractor

NE NE SE

El. 1898


SECTION PLAT

330 Ft. from N. Line

____ Ft. from S. Line

330 Ft. from E. Line

____ Ft. from W. Line

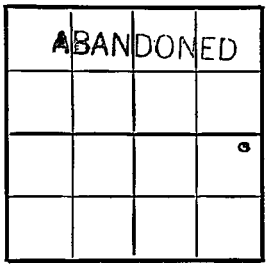

Stafford County

Location ____

Rig up ____

Drilling and Remarks:

9⅝ @ 300

Heb 3186

Br. L 3306

Lans 3318

BKC 3538

Cong 3558

Arb 3753

D & A.

RECORD

Cased ____ in., ____ ft.

Sand ____

Gas ____

Oil ____

Total Depth 3782

PRODUCTION

1st 24 hrs. Nat. ____

1st 24 hrs. after shot ____

Gas ____ Cu. Ft.

Dry Hole ____

Abandoned ____

Date

FEB 8 1950 19

J. E. TYRA Scout