


Section 5 Township 21 Range 13W

Well No. #1 Newcomb

Company Texas

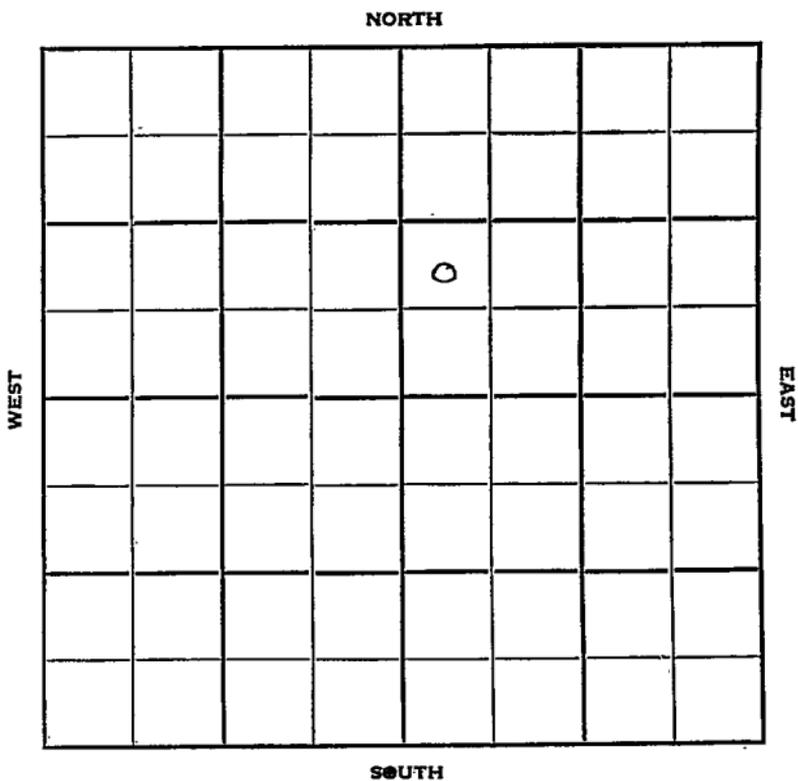

Sec. 5 Twp. 21 R. 13W

Well No. #1 Newcomb Farm

Texas Company

Braden Contractor
Dell


 Ft. from N. Line

990 Ft. from S. Line

 Ft. from E. Line

330 Ft. from W. Line

NW SW NE

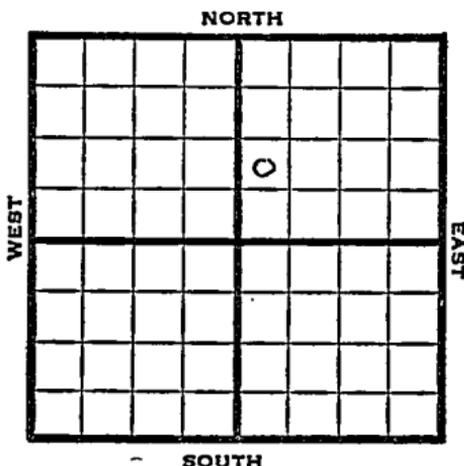

1952

Elev. 1900' REPORT

1/30 Spud 1-25-52
8" @ 770'
Drlg. 1675'

2/6 Heeb. 3187 Tor 3207
Br Li 3291 Lans 3308
DST 3419-34, 1 hr. 15' mud
Drlg.

2/13 Spud 1-25-52
D&A TD 3680
8" @ 770'
Heeb. 3187 Tor. 3207
Br lime 3291 Lans. 3308
DST 3419-34 opn 1 hr. Rec. 15' mud
Cong. 3550 Arb. 3579
DST 3581-3600 opn 1 hr
Rec. 5' mud DST 3603-11 opn 1 hr.
Rec. 20' mud DST 3604-20 opn 1 hr.
Rec. 30' vwo & gcm TD 3680
D&A **ABANDONED**


County Stafford State Kansas

Sec. 5 (Blk. 21) (Sur. Rge.) 13W Map No.

Operator Texas

Well No. 1 Farm Newcomb

Elev. _____ Location NW SW NE

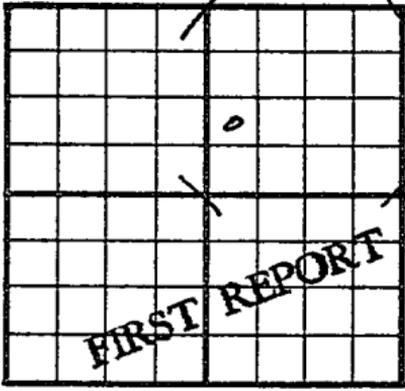

990 Ft. From S Line NE

330 Ft. From W Line Quarter

Ist. Report JAN 30 1952

Completion _____

Remarks _____


Braden - Contr.

Spudding Date 1-25-52

Drlg. Data De11

8" @ 770 Drlg. 1675

J. G. McGEHEE

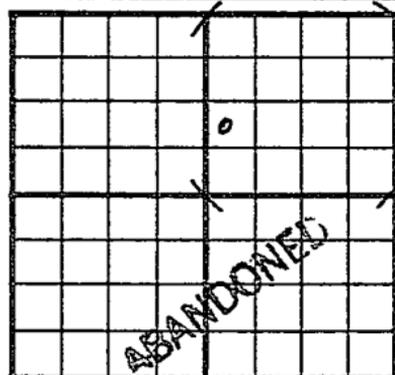County Stafford State KansasSec. 5 (Blk. 21 Twp.) (Sur. 13W Rge.) Map No.Operator Texas CompanyWell No. 1 Farm NewcombElev. 1900 Location NW SW NE990 Ft. From S Line NE330 Ft. From W Line Quarter

1st. Report

Completion FEB 13 1952Remarks Dell PoolBraden Drlg. - Contr.Spudding Date 1-25-52Drlg. Data D & A TD 36808" @ 770 Heeb. 3187 Tor. 3207Br. lime 3291 Lans. 3308 DST 3419-34open 1 hr. Rec. 15' mud Cong. 3550Arb. 3579 DST 3581-3600 open 1 hr.Rec. 5' mud DST 3603-11 open 1 hr.Rec. 20' mud DST 3604-20 open 1 hr.Rec. 30' vwo & gcm TD 3680D & A