


Section 5 Township 21 Range 13W

Well No. 3 Newcombe "A"

Company Petroleum Inc.

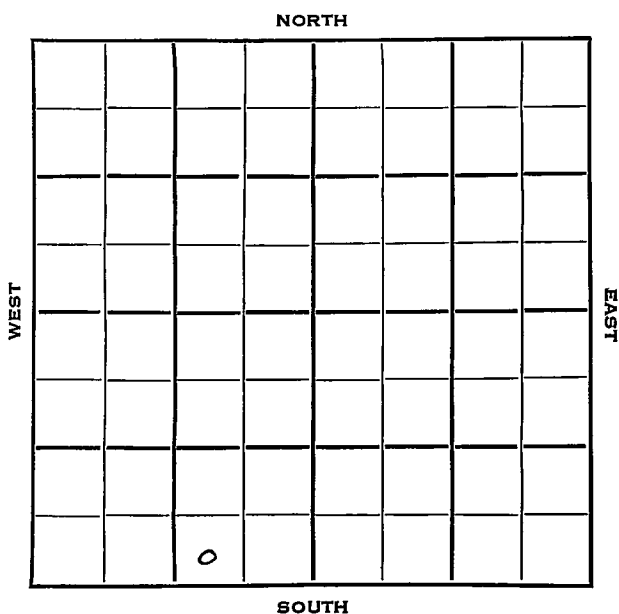

Sec. 5 Twp. 21 R. 13W

Well No. 3 Newcombe "A" Farm

Petroleum Inc. Company

Contractor

E. Dell Pool


         Ft. from N. Line

330 Ft. from S. Line

330 Ft. from E. Line

         Ft. from W. Line

SW SE SW

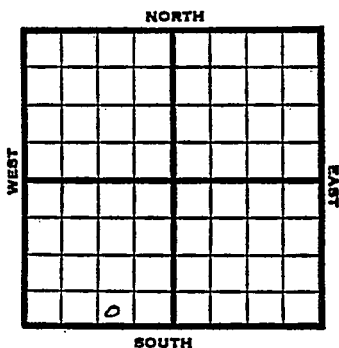

1953

Elev. 1908 REPORT

1/7

Spudding Date 1/2/53  
8" @ 218 Drlg. 2755

1/14

Spud 1-2-53  
D&A TD 3650  
8" @ 218  
Heeb 3195, Br lime 3315, Lans 3327  
DST 3442-63, opn 1/2 hr., rec. 15' mud  
DST 3485-3500, opn 1 hr., rec. 15' mud  
Arb 3548  
DST 3549-3602, opn 1 hr., rec. 5' mud  
DST 3598-3630, opn 1/2 hr., rec. 25' mud & soem 50#  
DST 3630-40, opn 1 hr., rec. 58' mud, 1190#  
TD 3650  
D&A

**ABANDONED**



