
FORM 51 25M 3-49 PETROL

Stafford KANSAS

Section 5 Township 21 Range 13 W

Well No. # 2 Newcombe "A"

Company Petroleum Inc.

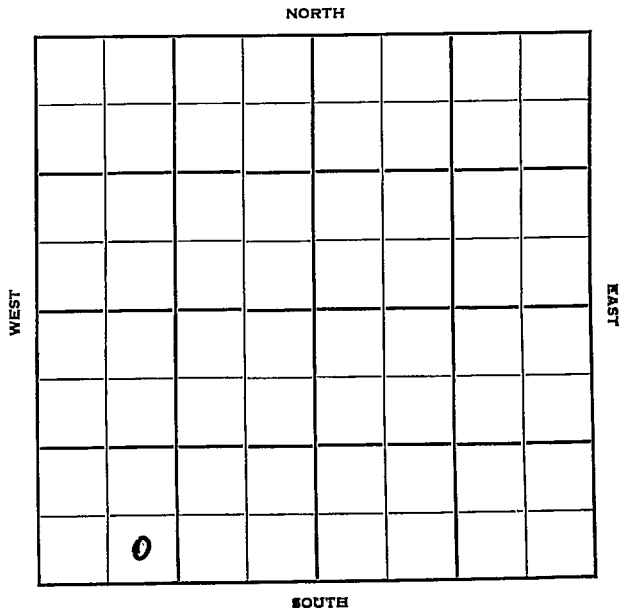

FORM 252-B
10M 11-50 PETROL

Stafford

KANSAS

Sec. 5 Twp. 21 R. 13W

Well No. #2 Newcombe "A" Farm

Petroleum Inc. Company

Petroleum Inc. Contractor

East Dale Pool


Ft. from N. Line

330 Ft. from S. Line

Ft. from E. Line

990 Ft. from W. Line

SE SW SW

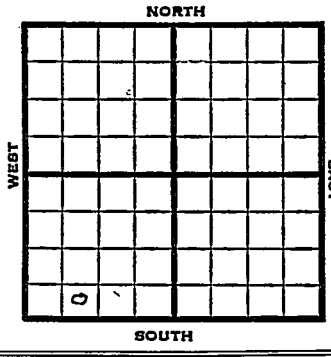

1952	Elev. 1906' REPORT
10/8	Spud 10-5-52 8" @ 205' Anhy 700' Drlg. 2100'
10/15	Heeb 3191 Br L 3307 Lans 3319 good show oil TD 3616' 5" @ 3590
10/22	PB 3523' 32/3476-84 500 A S/17 gal OPH 2000 A S/15 BOPH for 6 hrs.
10/29	500 BOPD
11/5 11/12	NR "
11/19	Spud 10-5-52 Oil Well TD 3616' 8" @ 205 Anhy 700, Heeb 3191, Br. lime 3307', Lans 3319, DST 3348-94, opn 1 hr., rec. 20' socm DST 3433-54, opn 1 hr., rec. 360' gassy oil, 60' hocm, 10' mud 1080# DST 3458-72, opn 1 hr., rec. 30' mud & oil 30' gassy oil

OVER

(Information Brought Forward)

1952
11/19 360' sw 1070#
DST 3475-89, opn 1 hr., rec.
30' gcm & 90' hocm 240' mo
60' clean oil 740#
TD 3616.
5" @ 3590
PB 3523, 32/3476-84, 500A
S/17 goph 2000A, S/15 boph
Comp. 500 boph

COMPLETED

FORM 275 FOR SALE BY KANSAS BLUE PRINT CO.


County Stafford State Kansas

Sec. 5 (Blk. Twp.) 21 (Sur. Rge.) 13W Map No.

Operator Petroleum Inc.

Well No. 2 Farm Newcombe "A"

Elev. Location SE SW SW

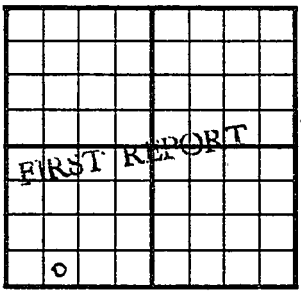

330 Ft. From S Line SW

990 Ft. From W Line Quarter

1st. Report OCT 8 1952

Completion

Remarks

Petroleum Inc. - Contr.

Spudding Date 10-5-52

Drlg. Data East Dale Pool

8" @ 205 Anhy 700 drlg. 2100

J. G. McGEHEE

Scout Cards .....
Land Small Map .....
Land Wall Map 3 .....
Tracings .....
France Map .....
Pierce Map .....
Misc. .....

OCT 13 1982

Drlg. Data

FORM 275 FOR SALE BY KANSAS BLUE PRINT CO.


County Stafford State Kansas

Sec. 5 (Blk. Twp.) 21 (Sur. Rge.) 13W Map No.

Operator Petroleum Inc.

Well No. 2 Farm Newcombe "A"

Elev. 1906 Location SE SW SW

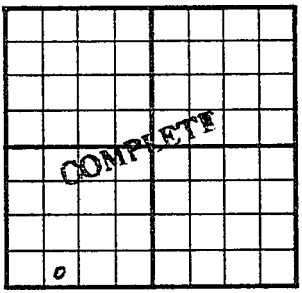

330 Ft. From S Line SW

990 Ft. From W Line Quarter

1st. Report

Completion NOV 19 195

Remarks East Dale Pool

Petroleum Inc. - Contr.

Spudding Date 10-5-52

Drlg. Data Oil well TD 3616

8" @ 205 Anhy 700 Heeb. 3191

Br. lime 3607 Lans. 3319 DST 3348-94

open 1 hr. Rec. 20' socm DST 3433-54

open 1 hr. Rec. 360' gassy oil 60' hocm

10' mud 1080# DST 3458-72 open 1 hr.

Rec. 30' mud & oil 30' gassy oil 360' sw

1070# DST 3475-89 open 1 hr. Rec. 30'


gcm & 90' hocm 240' mo 60' clean oil

740# TD 3616 5" @ 3590 PB 3523

32/ 3476-84 500 A S/ 17 goph 2000 A

S/ 15 boph Comp. 500 bopd

J. G. McGEHEE

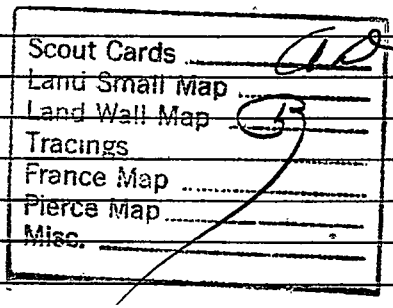
Scout Cards
Land Small Map
Land Wall Map
Tracings
France Map
Pierce Map
Misc.
NOV 25 1952

Drlg. Data