


FORM 51

Stafford

Section 5 Township 21 Range 13W

Well No. #2 Newcomb "B"

Company Petroleum Inc.

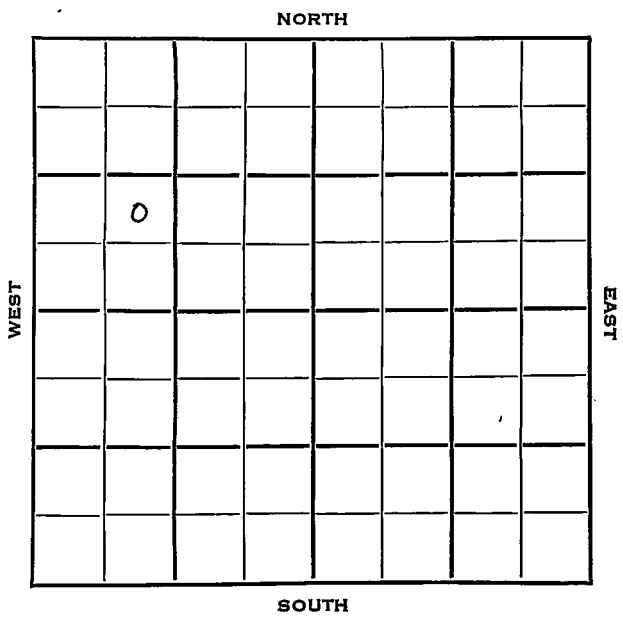

Stafford **KANAS** ✓

Sec. 5 Twp. 21 R. 13W

Well No. #2 Newcomb "B" Farm

Petroleum, Inc. Company

Garvey Contractor


_____ Ft. from N. Line

990 Ft. from S. Line

_____ Ft. from E. Line

990 Ft. from W. Line

NE SW NW

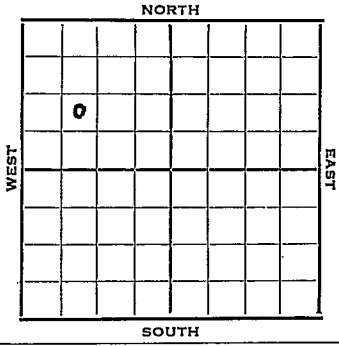

1953 Elev. 1909' REPORT

- 2/18 Spud 2-11-53
8" @ 217
Drlg. 2995'
- 2/26 Br li 3306, Lans 3317
DST 3360-3420, 1 hr., 120' M
1120#
DST 3440-53, 1/2 hr., 4' M 0#
DST 3460-3520, 3/4 hrs., 14' M
620#
Arb 3586
DST 3586-96, 1 hr., 360' gas,
230' oil, 0#
DST 3594-3606, 1 hr., 380'
oil, 600 #
RTD 3640,
4 1/2" @ 3639'
- 3/12 CO 3629
96/3584-3606, 1 1/4 BOPH 8 hrs.
41. G 2000A
- 3/19 5 1/2 BOPH 12 hrs., 30% wtr.
- 3/26 "
- 4/2 NR
- 4/9 "
- 4/16 "
- 4/23 NR
- 4/30 NR
- 5/7 "

OVER

#2 Newcomb "B"

1953
5/20

Spud 2-11-53

Oil Well

TD 3640

8" @ 217

Br lime 3306, Lans 3317

DST 3360-3420, opn 1 hr., rec. 120'
mud, 1120#

DST 3440-53, opn $\frac{1}{2}$ hrs., rec. 4' mud
0#

DST 3460-3520, opn $\frac{3}{4}$ hrs., rec. 14'
mud, 620#

Arb. 3586

DST 3586-96, opn 1 hr., rec. 360' gas,
230' oil, 0#

DST 3594-3606, opn 1 hr., rec. 380'
oil, 600#

TD 3640

5" @ 3639,

CO to 3629, 96/3584-3606, $1\frac{1}{4}$ BOPH
8 hrs., 2000A, $5\frac{1}{2}$ boph 12 hrs.

30% wtr.

Cong 3536, Simp 3566

Comp. 8 bopd 84% wtr.

COMPLETED

FEB 20 1958

Scout Cards	_____	AD
Land Small Map	_____	
Land Wall Map	_____	BR
Tracings	_____	
France Map	_____	
Pierce Map	_____	
Misc.	_____	

Dirig. Data

Scout Cards _____
Land Small Map _____
Land Wall Map _____
Tracings _____
France Map _____
Pierca Map _____
Misc. _____

MAY 26 1953

Orig. Data