


Section 5 Township 21 Range 13W

Well No. #1 Newcomb "C"

Company Petroleum Inc.

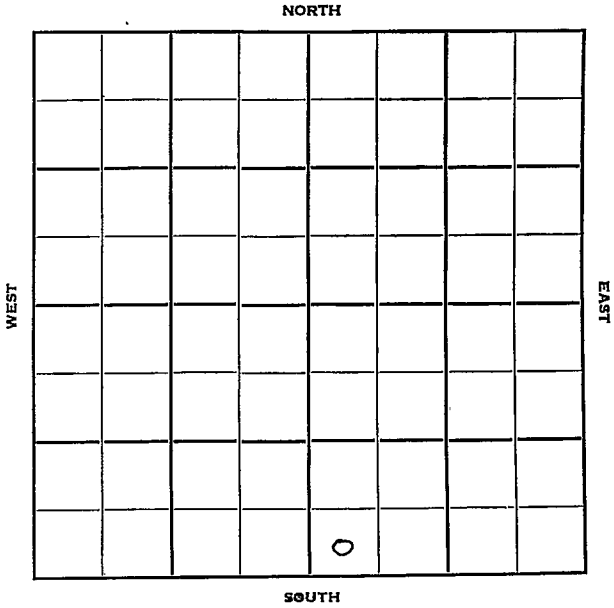

Stafford

KANSAS

Sec. 5 Twp. 21 R. 13W

Well No. #1 Newcomb "C" Farm

Petroleum, Inc. Company

Garvey - Contr. Contractor


_____ Ft. from N. Line

330' Ft. from S. Line

_____ Ft. from E. Line

330' Ft. from W. Line

SW SW SE

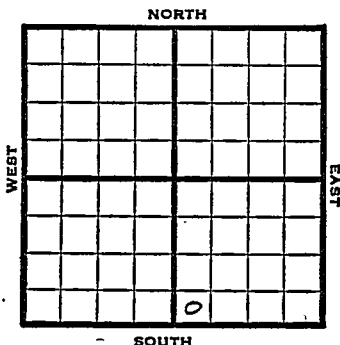

1952

Elev. 1907'

REPORT

5/14

Spud 5-7-52
8" @ 232
Anhy 780
Drlg. 3150'

5/21

Spud 5-7-52
D & A TD 3635' 8" @ 232
Anhy 780' Heeb 3201' Br. lime 3322'
Lans. 3333' Cong. 3583'
DST 3364-3432 open 1 hr. rec 90' mud
TD 3635' D & A

ABANDONED

