KANSAS


FORM 51 25M 8-50 WESTERN

Stafford

Section 5 Township 21 Range 14W

Well No. #1 Keller

Company Palmer Oil

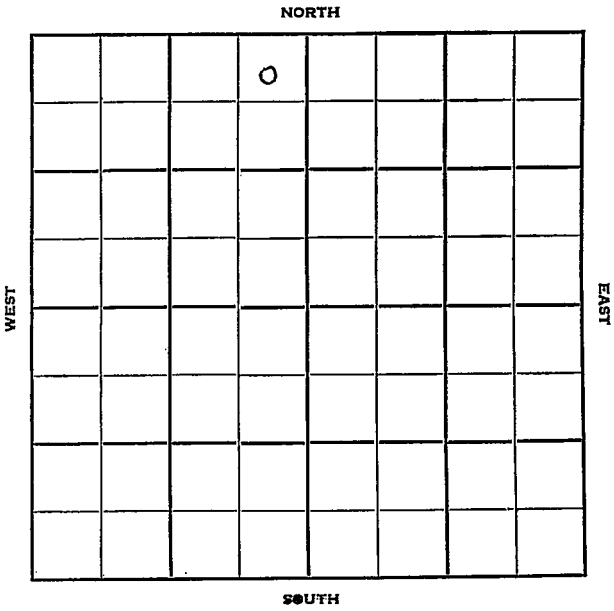

FORM 252-B
10M 11-50 PETROL

KANSAS

Stafford

Sec. 5 Twp. 21 R. 14-W

Well No. #1 Keller Farm

Palmer Company

Contractor


330 Ft. from N. Line

Ft. from S. Line

330 Ft. from E. Line

Ft. from W. Line

NE NE NW

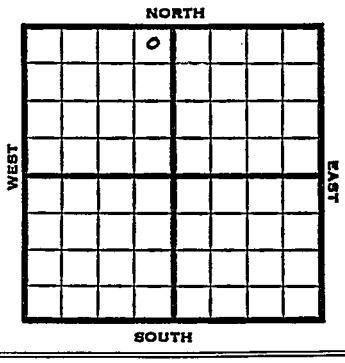

1951	Elev 1921' REPORT
1/3	Drlg
1/17	Spud 12-29-50 8" @ 862 Heeb 3208 Br lime 3310 Lans 3318 B KC 3522 Arb 3617 Simp 3586 DST 3619-30 opn 1 hr rec 300' water TD 3630' B&A ABANDONED

FORM 275 FOR SALE BY KANSAS BLUE PRINT CO.


County Stafford State Kansas

Sec. 5 (Blk. Twp.) 21 (Sur. Rge.) 14W Map No.

Operator Palmer Oil

Well No. 1 Farm Keller

Elev. 1921 Location NE NE NW

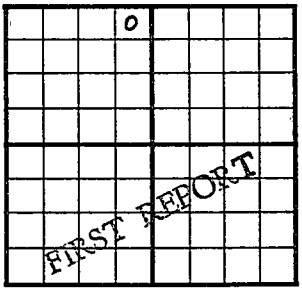

330 Ft. From N Line NW

330 Ft. From E Line Quarter

1st. Report JAN 3 1951

Completion

Remarks

Spudding Date

Drlg. Data

drlg.

J. E. TYRA

FORM 275 FOR SALE BY KANSAS BLUE PRINT CO.


County Stafford State Kansas

Sec. 5 (Blk. Twp.) 21 (Sur. Rge.) 14W Map No.

Operator Palmer Oil

Well No. 1 Farm Keller

Elev. 1921 Location NE NE NW

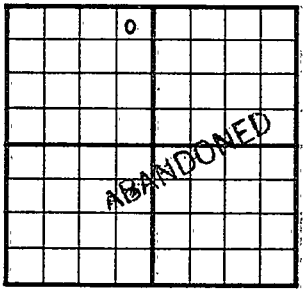

330 Ft. From N Line NW

330 Ft. From E Line Quarter

1st. Report

Completion

Remarks JAN 17 1951

Spudding Date 12-29-50

Drlg. Data D & A TD 3630

8" @ 862 Heeb. 3208 Br. lime 3310

Lans. 3318 B KC 3522 Arb. 3617

Simp. 3586 DST 3619-30 open 1 hr.

Rec. 300' water TD 3630

D & A

J. E. TYRA