

DX 78-1

Pawnee

5


21

KANSAS  
15W

Section \_\_\_\_\_ Township \_\_\_\_\_ Range \_\_\_\_\_

Well No. #2 Sprier

Company Alkay Oil

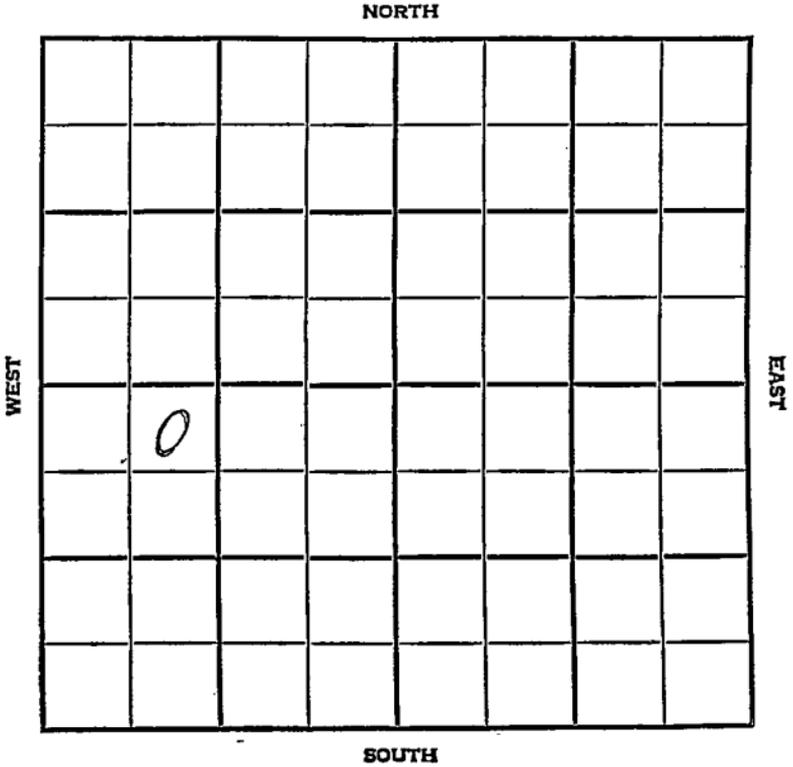

County Parmer Elev. 1958 DE  
1961 RB  
 Sec. 5 Twp. 21 Rge. 15W  
 Company Alkay Oil  
 Farm Name Sprier No. 2

TOPS	DEPTH	LOG	DATUM
Anb.	<u>946</u>		
Tp.			
H.			
Tr.			
Dg.			
Bl.			
L.			
K.C.			
B.K.C.			
Ce.			
C.			
M.			
M.			
K.			
Mz.			
Me.			
V.			
S.			
S.			
A.			
R.			
PE.			
G.			
T.D.			

Loc. in Sec. NE NW SW  
 Geol. \_\_\_\_\_  
 Contr. Smith-Wood  
 Pool Sweeney  
 FIRST REPORT  
 OCT 31 '56

Date Comm. 10-21-56  
8" @ 960/450 drlg. 2455

*[Handwritten signature]*

Co.  
 Loc.  
 No.  
 Sec.  
 T.  
 R.

17 1/2 IN DIAMETER  
 4 1/2 IN DIA  
 2 2

County Pawnee Elev. 1958 DT  
1961 RB  
 Sec. 5 Twp. 21 Rgs. 15W  
 Company Alkay Oil  
 FarmName Sprier No. 2

TOPS	DEPTH	LOG	DATUM
Anh.	946		
TP.			
H.	3313		
Tr.			
Dg.			
Bl.	3410		
L.	3420		
K.C.			
R.K.C.	3649		
Ce.			
C.			
M.			
M.			
K.			
Mz.			
Mo.			
V.	3674		
S.	3739		
S.			
A.	3762		
R.			
PE.			
G.			
TD.	3865		

Loc. in Sec. NE NW SW  
 Don Vaughn  
 Geol.  
 Contr. Smith-Wood  
 Pool Sweeney

COMPLETE	
DEC 5 '56	

Date Comm. 10-24-56  
8" @ 960/450 drlg. 2455 OCT 7 '56 X  
NO TOPS @ 3700 NOV 13 '56 DST  
3764-3822 cor 1 hr G/13" ga  
3.308 MCF/30" rec 120' sulp wtr  
BHP 1030/20 DST 3829-35' 1 hr  
G/11" TSTM rec 100' sulp wtr  
BHP 820/20 5 1/2 @ 3864 NOV 21 '56  
RUCT CO. NOV 28 '56 18/3840-43 TST  
wtr PB 3848 54/3768-85 DEC 5 '56

18/3769-72 68/3775-86

30" or Flw 4,820 MCF

2" T69 FCR 640 10" 9a

4,735 MCF in 56" 9a 4,735

MCF 24 hr SICR 870 #.

gas sour BTU 1000

complete.

KPL will take gas

5-21-15

re m. su