


Rice
KANSAS

Section.....5.....Township.....21.....Range.....7W.....

Well Number.....1.....Gossman.....

Company.....Eldorado Ref., et al.....

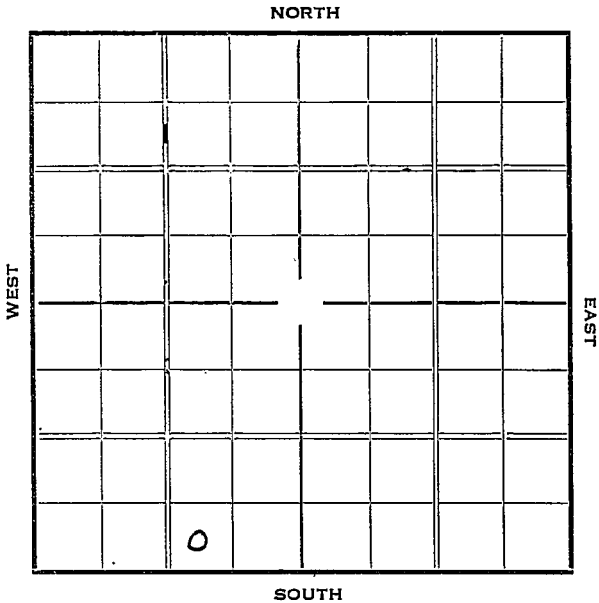

Sec. 5 Twp. 21 R. 7-W

Well No. #1 Gossman Farm

Eldorado Refg. et al Company


Ft. from N. Line

330 Ft. from S. Line

990 Ft. from E. Line

Ft. from W. Line

Elev. 1623

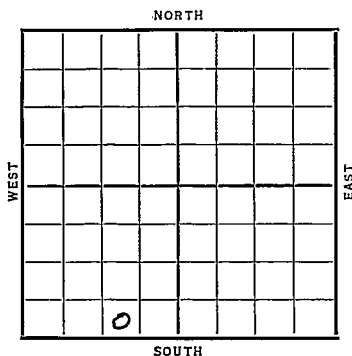[illegible]

KANSAS

Map No. 49 Sec. 5 Twp. 21 R. 7WWell No. 1 GossmanEldorado Ref. & T^o Company

Contractor

SECTION PLAT

_____ Ft. from N. Line

320 Ft. from S. Line990 Ft. from E. Line

_____ Ft. from W. Line

REPORT

RECORD

Location _____

Cased _____ in., _____ ft.

Rig up _____

Sand _____

Drilling and Remarks:

Gas _____

Oil _____

Total Depth _____

PRODUCTION

1st 24 hrs. Nat. _____

1st 24 hrs. after shot _____

Gas _____ Cu. Ft.

Dry Hole _____

Abandoned _____

Date

NOV 25 1924

S. J. LEWIS Scout

KANSAS

Map No. 49 Sec. 5 Twp. 21 R. 7W

Well No. 1 Goseman

El Dorado Ref & Co. Company

Contractor

SECTION PLAT

17 Ft. from N. Line

270 Ft. from S. Line

990 Ft. from E. Line

_____ Ft. from W. Line

COMPLETED

Location _____

Rig up _____

Drilling and Remarks:

Ok 83368.

Pa 860 8W

RECORD

Cased _____ in., _____ ft.

Sand _____

Gas _____

Oil _____

Total Depth 3382

PRODUCTION

1st 24 hrs. Nat. _____

1st 24 hrs. after shot _____

Gas _____ Cu. Ft.

Dry Hole _____

Abandoned _____

Date

JAN 20 1937

S. J. LEWIS Scout