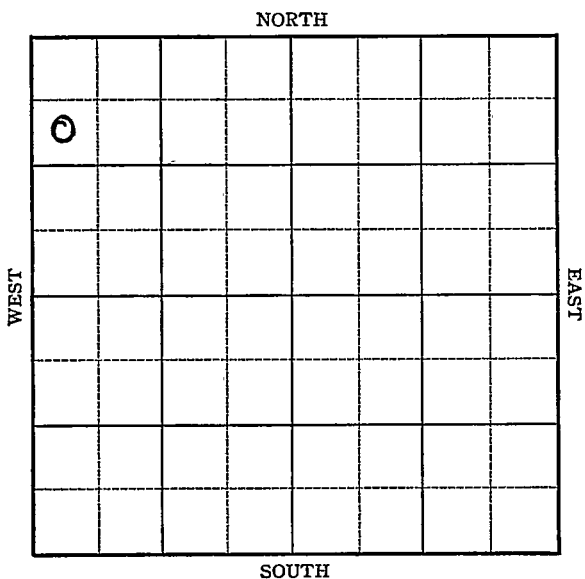



Section 5 Township 21 Range 7-WWell No. #2 OdenCompany Republic Nat. Gas

KANSAS

Rice

Sec. 5 Twp. 21 R. 7WWell No. 2- Oden FarmRepublic Nat. Gas Company990 Ft. from N. Line Ft. from S. Line Ft. from E. Line330 Ft. from W. Line

Elev. 1623

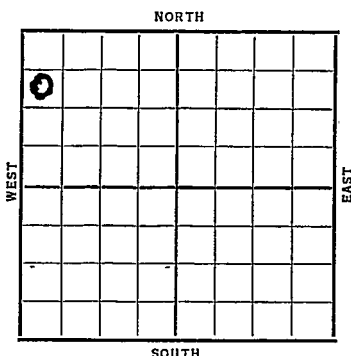

Date	REPORT
1937	
8/11	RUR
8/20	10" @ 105'. Drlg. 1680'.
8/28	Drlg. 3065'.
9/3	7" @ 3328'. Cong. 3337'.
	T.D. 3350'. 1500' oil.
	5" perforated liner @ 3350'.
9/10	T.D. 3353'. Swab 32 B.O. & S.W.
	P.B. 3350'.
9/17	Will shoot.
9/24	Shot 20 qts. 3325-45'. C.O.
10/2	Shot 50 qts. 3335-45'. C.O.
10/8	Shut down.
10/15	" "
10/22	" "
10/29	" "
11/5	" "
11/12	" "
11/19-	" "
11/26	" "
	OVER

1937

12/1

7" @ 3328'.

Cong. 3337'.

T.D. 3353'.

P.B. 3350'.

Shot 70 qts.

ABANDONED

Rice KANSAS

Map No. _____ Sec. 5 Twp. 21 R. 7WWell No. 2 - OdenRepublic Nat Gas Company

Contractor

FIRST REPORT

SECTION PLAT

0			

990 Ft. from N. Line

_____ Ft. from S. Line

_____ Ft. from E. Line

530 Ft. from W. Line

Location _____

Rig up _____

Drilling and Remarks:

R. U. R.

RECORD

Cased _____ in., _____ ft.

Sand _____

Gas _____

Oil _____

Total Depth _____

PRODUCTION

1st 24 hrs. Nat. _____

1st 24 hrs. after shot _____

Gas _____ Cu. Ft.

Dry Hole _____

Abandoned _____

Date

AUG 11 1937₁₉H. D. Hatfield Scout

22

[Handwritten signature]

RAY

Returned	
Cards	<i>[Signature]</i>
Tracing	<i>[Signature]</i>
France Map	<i>[Signature]</i>
Scarborough Map	<i>[Signature]</i>
Moody Map	<i>[Signature]</i>
Scarborough Plat Book	
Moody Plat Book	

Rice

KANSAS

Map No. 49 Sec. 5 Twp. 21 R. 7WWell No. 2 OdenRepublic Natural Company

Contractor

ABANDONED

SW NW NW

990 Ft. from N. Line

_____ Ft. from S. Line

_____ Ft. from E. Line

330 Ft. from W. Line

SECTION PLAT

0			

Location _____

Rig up _____

Drilling and Remarks:

*P.B. 3350**shot 70 gts**DYA*

RECORD

Cased 7 in. 3328 ft.~~Sand~~ *Cong* 3337

Gas _____

Oil _____

Total Depth 3353

PRODUCTION

1st 24 hrs. Nat. _____

1st 24 hrs. after shot _____

Gas _____ Cu. Ft.

Dry Hole _____

Abandoned _____


Date

DEC 1 - 1937

19

H. D. Hatfield

Scout

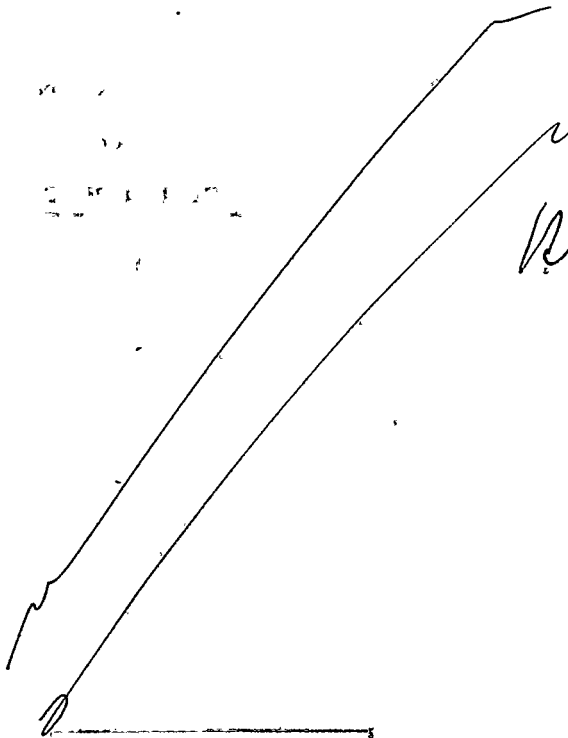

Handwritten signature or initials.

1	twice
2	
3	

Moody Flat Book _____
 Scarborough Flat Book _____
 Moody Flat Book _____