

Rice


KANSAS

Form 51—5M—4-36—Palace

Section 5 Township 21 Range 7-W

Well Number 2 Patton "C"

Company Atlantic Ref.

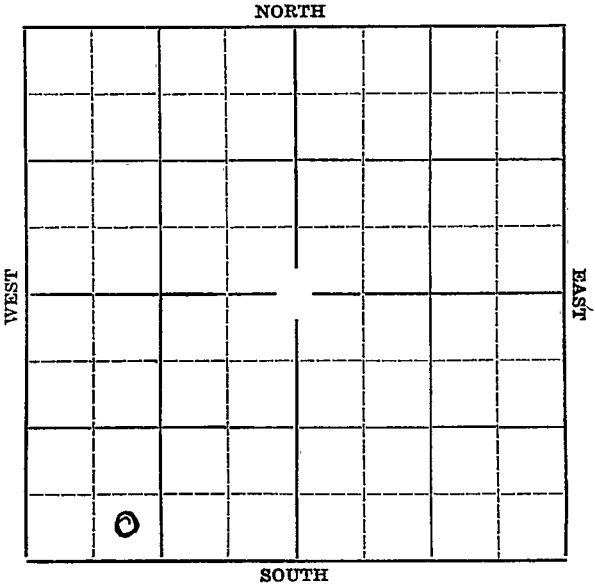

Map No. _____ Sec. 5 Twp. 21 R. 7WWell No. 2. Patton "C"Atlantic Ref. Company_____
Contractor

SECTION PLAT

Ft. from N. Line380 Ft. from S. Line_____
Ft. from E. Line990 Ft. from W. Line

FIRST REPORT

Location _____

Rig up _____

Drilling and Remarks:

R.O.G.

RECORD

Cased _____ in., _____ ft.

Sand _____

Gas _____

Oil _____

Total Depth _____

PRODUCTION

1st 24 hrs. Nat. _____

1st 24 hrs. after shot _____

Gas _____ Cu. Ft.

Dry Hole _____

Abandoned _____

Date

APR 21 1937₁₉S. J. LEWIS Scout

Rice **KANSAS**Map No. _____ Sec. 5 Twp. 21 R. 7 ^WWell No. 2-Patton "C"Atlantic Company

Contractor

COMPLETED**SECTION PLAT**

0			

_____ Ft. from N. Line

330 Ft. from S. Line

_____ Ft. from E. Line

990 Ft. from W. Line

Location _____

Rig up _____

Drilling and Remarks:

Pot 682/246 hr Test**RECORD**Cased 7 in., 3327 ft.Sand cong 3329

Gas _____

Oil _____

Total Depth 3334**PRODUCTION**

1st 24 hrs. Nat. _____

1st 24 hrs. after shot _____

Gas _____ Cu. Ft.

Dry Hole _____

Abandoned _____

Date

MAY 26 1937

19

H. D. Hatfield Scout