DX 78-1


Rice

KANSAS

Section 5 Township 21S Range 7W

Well No. 1 Odin

Company Bennett-Gould

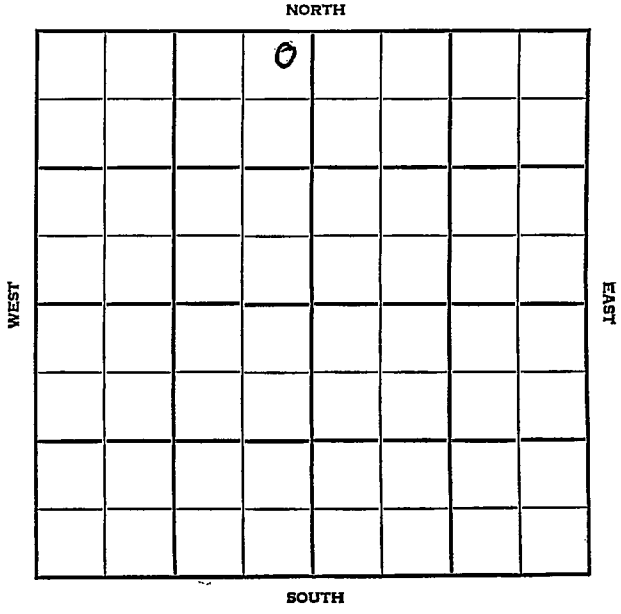

Rice

KANSAS

SEC.	TWP.	R.
5	21S	7W

WELL NO.

#1 Odin FARM

COMPANY

Bennett-Gould

CONTRACTOR

Salina


_____ Ft. from N. Line

_____ Ft. from S. Line

_____ Ft. from E. Line

_____ Ft. from W. Line

NE NE NW

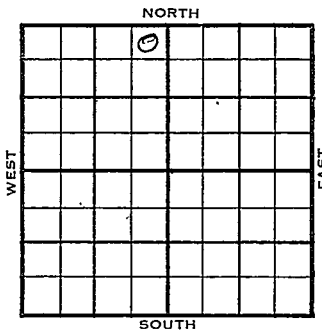

	ELEVATION
1955	1623 RB, 1620 DF REPORT
7/6	Comm MIRT
12-7	Comm. 7-5-55 8 5/8" @ 185/150 5½" @ 3326 DD 3362 PB 3335, 500 A, S/ ½ boph wtr. Temp. abd. BL 2855 L. 2882 C. 3325 TD 3329'

ABANDONED

DX-78

FORM 513 REV. SUNRAY

County Rice Elev.

Sec. 5 Twp. 21S Rge. 7W

Company Bennett- Gould

Farm Name Odin No. 1


TOPS	DEPTH	LOG	DATUM
Anh.			
Tp.			
H.			
Tr.			
Dg.			
Bl.			
L.			
K.C.			
B.K.C.			
Ce.			
C.			
M.			
M.			
K.			
Mz.			
Mc.			
V.			
S.			
S.			
A			
R.			
P€.			
G.			
T.D.			

Loc. in Sec. NE NE NW

Geol.

Contr. Salina

Pool

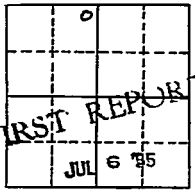

Date Comm. MTRT

Co. Lse. No. Sec. T. R.

FORM 513 REV. SUNRAY

County Rice — Elev. ~~1623 RB~~ 1620 DF

Sec. 5 — Twp. 21 — Rge. 7W

Company Bennett - Gould

Farm Name Odin — No. 1


TOPS	DEPTH	LOG	DATUM
Anh.			
Tp.			
H.			
Tr.			
Dg.			
Bl.	2855		1235
L.	2882		1262
K.C.			
B.K.C.			
Ce.			
C.	3325		1705
M.			
M.			
K.			
Mz.			
Mq.			
V.			
S.			
S.			
A			
R.			
Pe.			
G.			
T.D.	3329		

Loc. in Sec. NE NE NW

Geol.

Contr. Salina

Pool

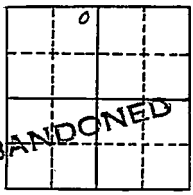

Date Comm. 7-5-55 — DEC 7 1955

8 5/8" @ 185/150 — 5½" @ 3326 — DD 3362

PB 3335 — 500 A — S/ ⅓ boph — wtr.

Temp. abd.

Co. Lse. No. Sec. T. R.