FORM 51 25M 8-50 WESTERN


Rice

KANSAS

Section 5 Township 21 Range 7W

Well No. #1 Wilhaus

Company ~~Petroleum, Inc.~~

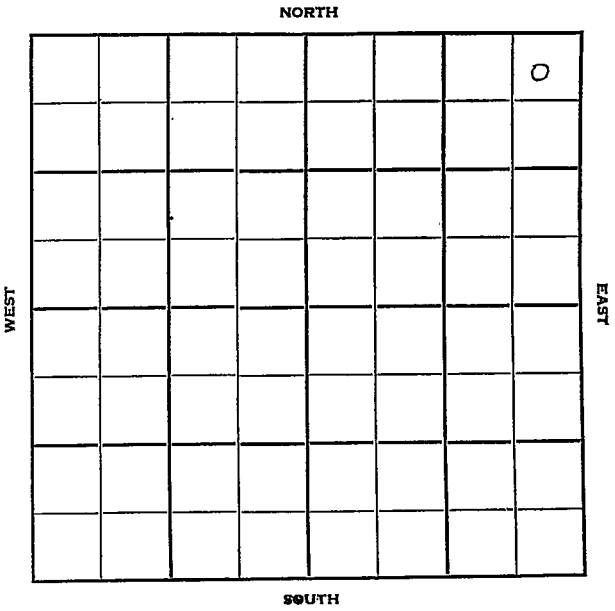

FORM 252-B
10M 10-50 PETROL

Rice KANSAS

Sec. 5 Twp. 21 R. 7W

Well No. #1 Wilhaus Farm

Petroleum, Inc. Company

Ayward Drlg. - Contr. Contractor

Wherry Pool


330' Ft. from N. Line

Ft. from S. Line

330' Ft. from E. Line

Ft. from W. Line

NE NE NE

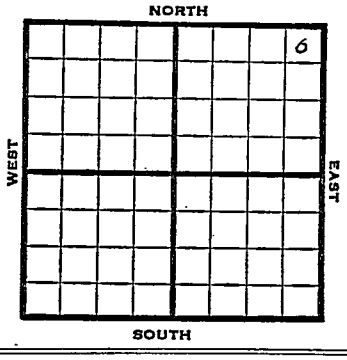

1950	Elev. 1620' REPORT
11/29	Spud 11-24-50 8" @ 127' Drlg. 1825'
12/13	Spud 11-24-50 D&A TD 3373 8" @ 127 Cong. 3327 Ch Cong. 3349 DST 3340-53 opn 45 min Rec. 7' mud DST 3347-64 opn 1 hr Rec. 30' mud Miss 3364 TD 3373 D&A ABANDONED

FORM 275 FOR SALE BY KANSAS BLUE PRINT CO.


County Rice State Kansas

Sec. 5 (Blk. Twp.) 21 (Sur. Rge.) 7W Map No.

Operator Petroleum Inc.

Well No. 1 Farm Wilhaus

Elev. Location NE NE NE

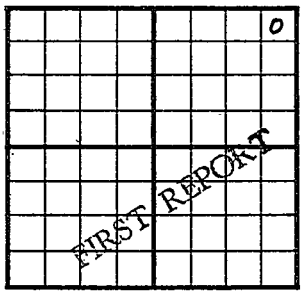

330 Ft. From N Line NE

330 Ft. From E Line Quarter

1st. Report NOV 29 1950

Completion

Remarks B & R Farmout

Aylward Drlg. - Contr.

Spudding Date 11-24-50

Drlg. Data Wherry Pool

8" @ 127 drlg. 1825

J. E. TYRA

FORM 275 FOR SALE BY KANSAS BLUE PRINT CO.


County Rice State Kansas

Sec. 5 (Blk. Twp.) 21 (Sur. Rge.) 7W Map No.

Operator Petroleum Inc.

Well No. 1 Farm Wilhaus

Elev. 1620 Location NE NE NE .

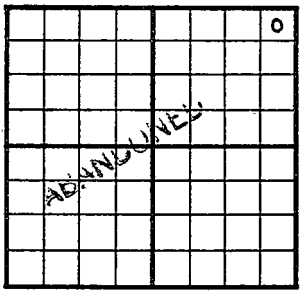

330 Ft. From N Line NE

330 Ft. From E Line Quarter

1st. Report

Completion DEC 13 1950

Remarks Wherry Pool

Aylward Drlg. - Contr.

Spudding Date 11-24-50

Drlg. Data D & A TD 3373

8" @ 127 Conc. 3327 Ch. Conc. 3349

DST 3340-53 open 45 min. Rec. 7' mud

DST 3347-64 open 1 hr. Rec. 30' mud

Miss. 3364 TD 3373 D & A

J. E. TYRA