


Stafford

DX 78-1

Section 5 Township 21 Range 11W

Well No. #1 Kasselmann "B"

Company Duke & Wood

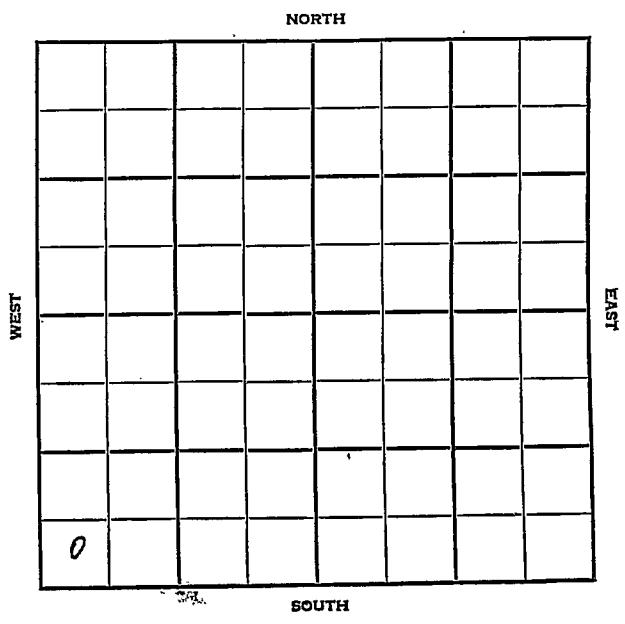

Stafford KANSAS


SEC.	TWP.	R.
5	21	11 W

WELL NO. **# 1 Kasselman "B"** FARM

COMPANY **Duke & Wood**

CONTRACTOR **Co. tools**

San Dago Pool
 _____ Ft. from N. Line
330 _____ Ft. from S. Line
 _____ Ft. from E. Line
330 _____ Ft. from W. Line

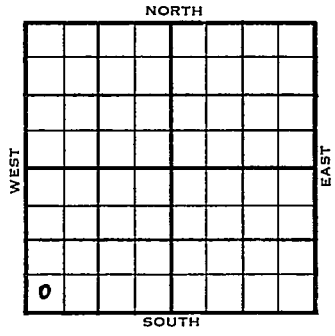

SW SW SW

	ELEVATION	REPORT
1954	1802'	
12/29		Spud 12-23-54 8" @ 235 WOG
1955 2/9		Spud 12-23-54 - Oil Well TD 3444' 8" @ 235' Anhy 573', Heeb ₂ 2996', Dodge 3013', Br lime 3120', ans 3137' DST 3198-3236', opn 1 hr., rec. 2300' gas, 225 HOCM, 45' SW, 985# Simp. sh. 3382', Simp. sd 3394' DST 3379-3430', opn 1 hr., rec. 65' WM, 575# Arb. 3439' TD 3444' 5" @ 3440' CO to 3260' 24/3218-32, 1500A 3 boph PB 3223', 24/3214-19, 1000A S/7 bfph 50% wtr. Comp. 20 bopd 20 bw

COMPLETED

County Stafford State Kansas

Sec. 5 (Blk.) 21 (Sur.) 11W Map No.

Operator Duke & Wood

Well No. 1 Farm Kasselman "B"

Elev. 1802 Location SW SW SW

0					

COMPLETED

330 Ft. From S Line SW

330 Ft. From W Line Quarter

1st. Report

Completion FEB 9 1955

Remarks San Dago Pool

Co. tools

Spudding Date 12-23-54

Drlg. Data Oil well TD 3444

8" @ 235 Anhy 573 Heeb. 2996

Dodge 3013 Br. lime 3120 Lans. 3137

DST 3198-3236 open 1 hr. Rec. 2300' gas

225' hocm 45' sw 985# Simp. sh. 3382

Simp. sd. 3394 DST 3379-3430

open 1 hr. Rec. 65' wm 575# Arb. 3439

TD 3444 5" @ 3440 CO to 3260

24/ 3218-32 1500 A 3 boph PB 3223

24/ 3214-19 1000 A S/ 7 bfph 50% wtr.

Comp. 20 bopd 20 bw

FABEN GILSTRAP