


Section 5 Township 21 Range 12W

Well No. 1 Siéker

Company Beardmore Drlg.

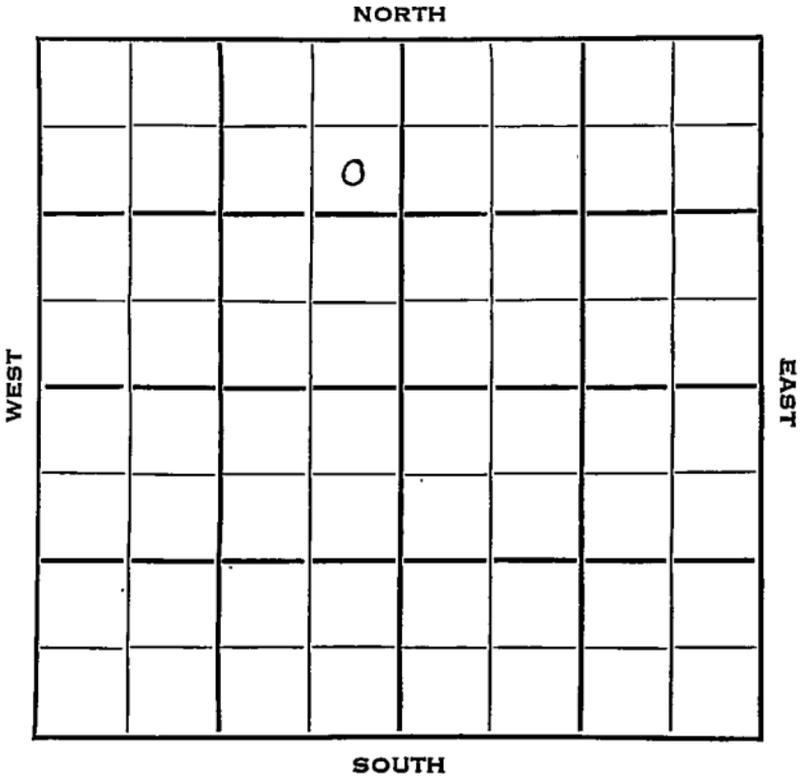

Stafford

KANSAS ✓

Sec. 5 Twp. 21 R. 12 W

Well No. # 1 Sieker Farm

Beardmore Drlg. Company

Wildcat Contractor


990 Ft. from N. Line

Ft. from S. Line

330 Ft. from E. Line

Ft. from W. Line

SE NE NW

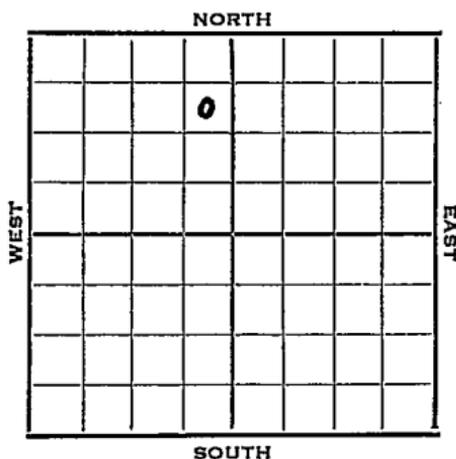

1953 Elev. 1851' REPORT

4/8 Location  
 4/16 8" @ 256'  
 4/23 Heeb 3065 Br li 3192 Lans 3210  
 DST 3214-63, 1 hr, 15' M Off  
 Drlg. 3390'  
 4/29 Spud 4-12-53  
 D & A  
 TD 3510'  
 8" @ 256'  
 Heeb 3065, Br. Lime 3192, Lans 3210,  
 DST 3214-63 opn 1 hr. rec 15' mud,  
 Off Arb 3448,  
 DST 3449-70 opn 1 hr, rec 60' ocm  
 450#  
 DST 3470-90 opn 1 1/3 hr. Rec 60' wtr.  
 650#  
 TD 3510'  
 D & A

**ABANDONED**

County Stafford State Kansas

Sec. 5 (Blk. Twp.) 21 (Sur. Rge.) 12W Map No.

Operator Beardmore Drlg.

Well No. 1 Farm Sieker

Elev. \_\_\_\_\_ Location SE NE NW


FIRST REPORT

990 Ft. From N Line NW

330 Ft. From E Line Quarter

Ist. Report APR 8 1953

Completion \_\_\_\_\_


Remarks \_\_\_\_\_

Spudding Date \_\_\_\_\_

Drlg. Data Wildcat

Location

County Stafford State Kansas  
 Sec. 5 (Blk. Twp.) 21 (Sur. Rge.) 12W Map No.  
 Operator Beardmore Drlg.  
 Well No. 1 Farm Sieker  
 Elev. 1851 Location SE NE NW

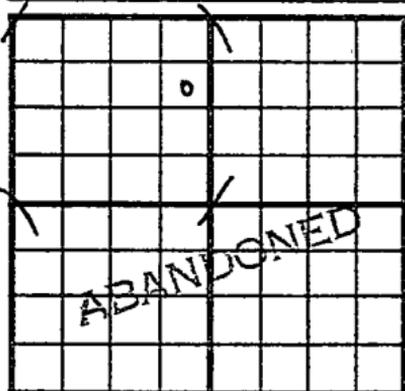

990 Ft. From N Line NW  
330 Ft. From E Line Quarter  
 Ist. Report  
 Completion APR 29 1953  
 Remarks Wildcat

Spudding Date 4-12-53

Drlg. Data D & A TD 3510

8" @ 256 Heeb. 3065 Br. lime 3192

Lans. 3210 DST 3214-63 open 1 hr.

Rec. 15' mud 0# Arb. 3448 DST 3449-70

open 1 hr. Rec. 60' ocm 450#

DST 3470-90 open 1 1/3 hr. Rec. 60' wtr.

650# TD 3510

D & A