

**OWWO**

FORM 57 25M '8-50 WESTERN


Stafford

**KANSAS**

Section 6 Township 21 Range 13W

Well No. #1 Morrison

Company SUNRAY MID\*CONTINENT

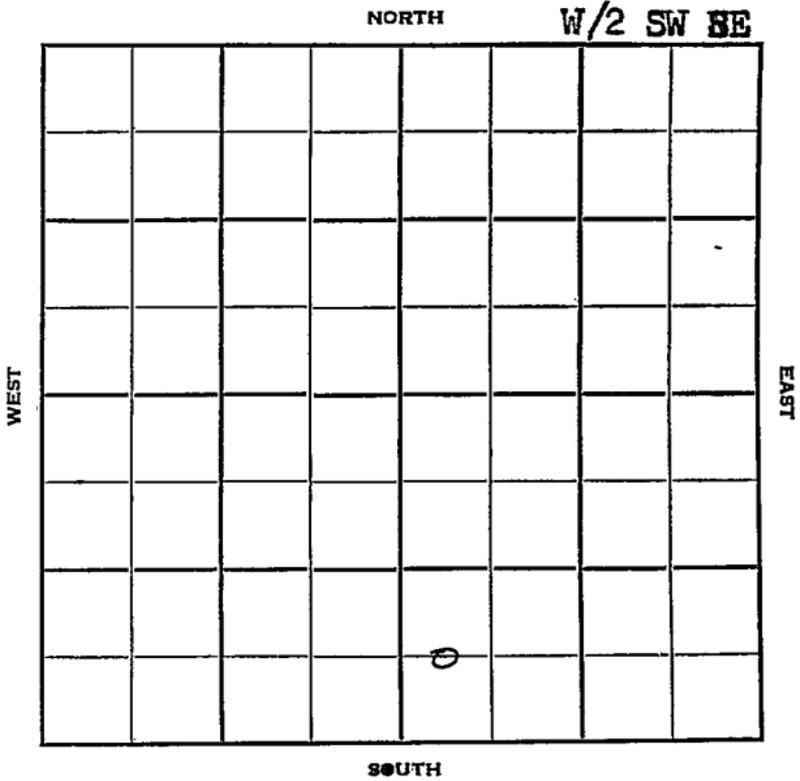

Well No. #1 Morrison Farm

Sunray Mid-Continent Company

Rosencrantz + Bemis  
Mouser Drlg. - Contr. Contractor

E. Dell Pool


         Ft. from N. Line

660' Ft. from S. Line

         Ft. from E. Line

330' Ft. from W. Line

*OF SE/4  
C W/2 SW SE*

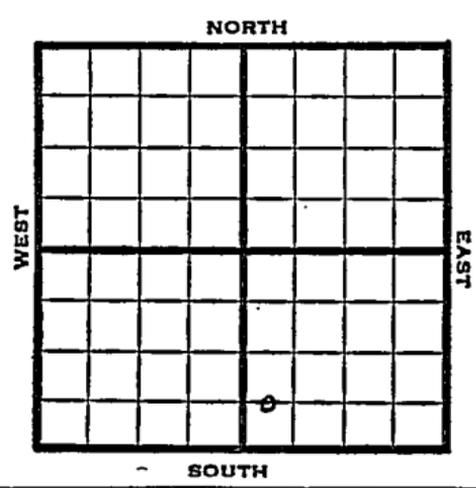

1950 Elev 1913' REPORT

11/22 MIR  
1951  
1/17 Spud 11-22-50  
Anhy 793  
8" @ 810  
Heeb 3204 Toronto 3224  
Br lime 3320 Lans 3332  
DST 3451-62 opn 1/2 hr rec 180' o&gcm  
SO 3493-97  
DST 3486-3500 opn 1 hr rec 30' o&gcm  
60' water  
Cong 3556 Viola 3561  
Simp 3565 Arb 3616  
TD 3618  
5" @ 3617  
SP 3555  
16/3459-63  
2000 A S/20 boph went to water  
SP 3468  
4/3459-61 250 A S/2 bph  
250 1/2 go 19 bwph  
D&A TD 3618'

ABANDONED  
O.W.W.O.

1958  
5/15 RE-ENTRY 1900' Test  
Spudded 4-17-58  
5 1/2" @ 1821' TD 2121' Salt Water  
Disposal Well. Open hole 1821-2050'  
Winfield Zone. Complete (DR#95)  
(FR & Comp. by Proa. DDR)


County **Stafford** State **Kansas**

Sec. **6** (Blk. Twp.) **21** (Sur. Rge.) **13W** Map No.

Operator **Sunray**

Well No. **I** Farm **Morrison**

Elev. Location **C W 1. SW SE**

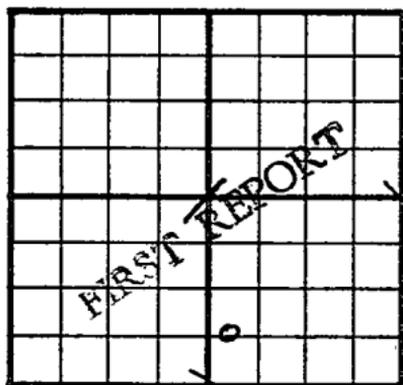

**660** Ft. From **S** Line **SE**

**330** Ft. From **W** Line **Quarter**

1st. Report **NOV 22 1950**

Completion

Remarks

**Mouser Drlg. - Contr.**

Spudding Date

Drlg. Data **Dell Pool**

**M I R**


County Stafford State Kansas

Sec. 6 (Blk. 21) (Sur. 13W) (Rge. Map No.)

Operator Sunray

Well No. 1 Farm Morrison

Elev. 1913 Location C W L SW SE

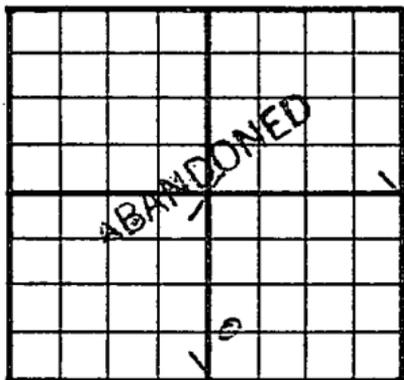

660 Ft. From S Line SE

330 Ft. From W Line Quarter

1st. Report

Completion JAN 17 1951

Remarks Dell Pool

Mouser Drlg. - Contr.

Spudding Date 11-22-50

Drig. Data D & A TD 3618

Anhy 793 8" @ 810 Heeb. 3204

Toronto 3224 Br. line 3320 Lans. 3332

DST 3451-62 open 1/2 hr. Rec. 180' o & gcm

SO 3493-97 DST 3486-3500 open 1 hr.

Rec. 30' o & gcm 60' water Cong. 3556

Viola 3561 Simp. 3565 Arb. 3616

TD 3618 5" @ 3617 SP 3555 16/ 3459-63

2000 A S/ 20 boph went to water

SP 3468 4/ 3459-61 250 A S/ 2 bfph

250 1/2 go 19 gwph

D & A

J. E. TYRA