


Section 6 Township 21 Range 13W

Well No. #3 Morrison

Company Westgate-Greenland

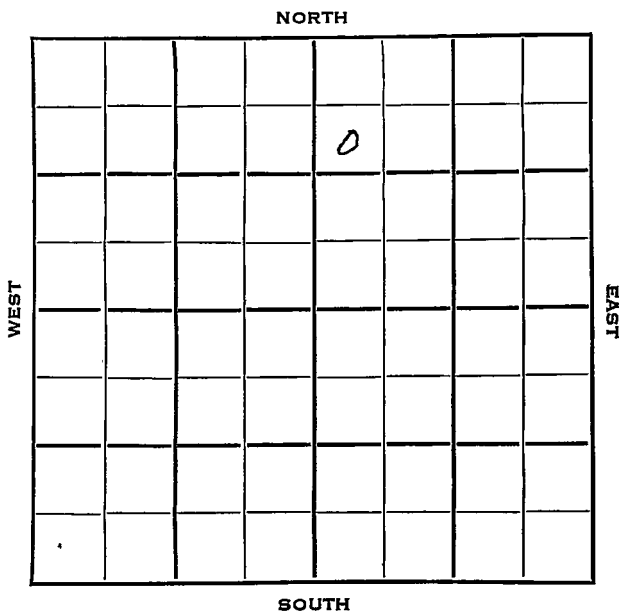

Sec. 6 Twp. 21 R. 13 WWell No. # 3 Morrison FarmWestgate-Greenland Company

Contractor


990 Ft. from N. Line

Ft. from S. Line

Ft. from E. Line

330 Ft. from W. Line

SW NW NE

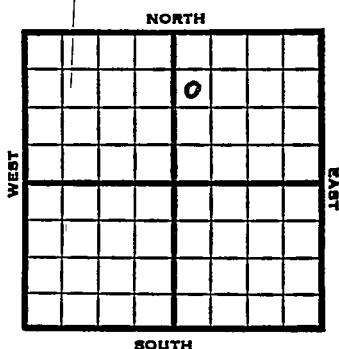

1953 Elev. 1912' REPORT

3/11 Location

3/19 10" @ 241  
Drlg. 2015'

3/26 Drlg. 3571'

4/1 Spud 3-13-53

D &amp; A TD 3650' 10" @ 241

Anhy 796' Heeb 3197' Br li 3313'

Lans. 3324' B KC 3527 Arb. 3598'

DST 3596-3605, open 1 hr, rec 105'  
mud. 1210#DST 3600-12, open 1 hr, rec 50' mud  
760#DST 3613-19 open 1 hr, rec 30' mud  
1070#DST 3616-26 open 1 hr, rec 35' SW  
960# TD 3650' D & A**ABANDONED**



