


Section 6 Township 21 Range 13W

Well No. #1 Morrison

Company Westgate-Greenland

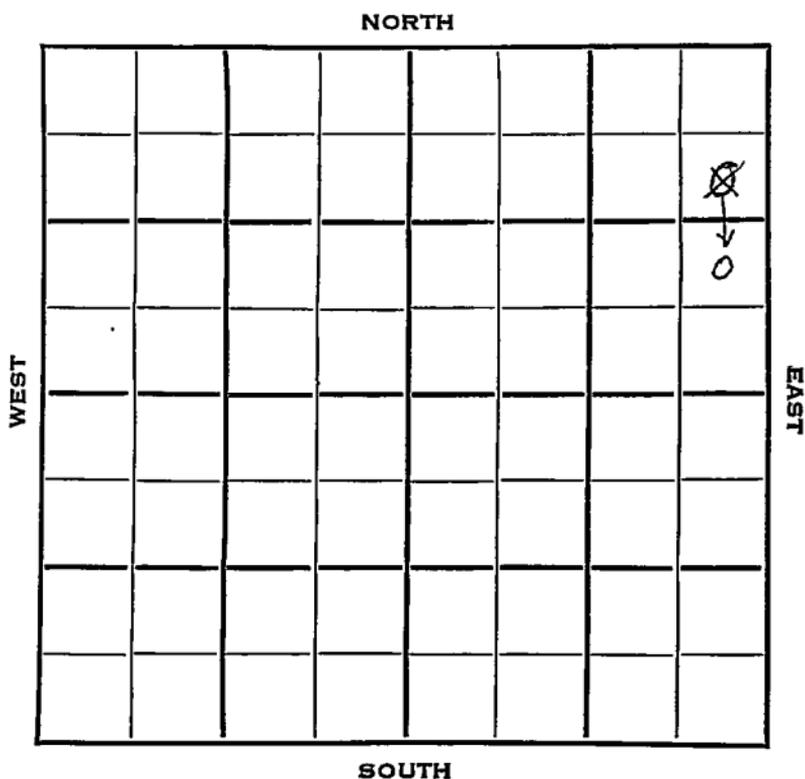

Sec. 6 Twp. 21 R. 13W

Well No. #1 Morrison Farm

Westgate-Greenland Company

W-G Contractor

E. Dell Pool


 Ft. from N. Line

990 Ft. from S. Line

330 Ft. from E. Line

 Ft. from W. Line

NE SE NE

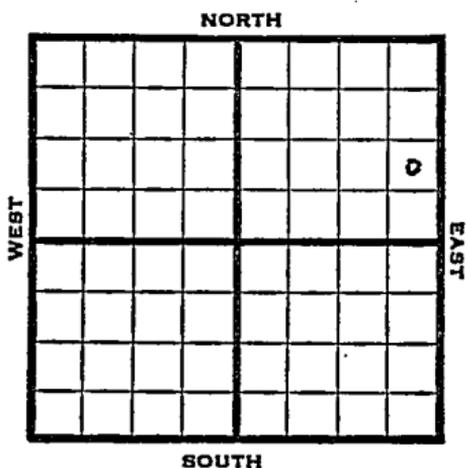

1953

Elev. 1905' REPORT

4/29

Location

5/7

10" @ 218'
Drlg 2990'

5/13

Spud 4-29-53 D & A TD 3666
10" @ 218 Anhy 788 Heeb 3195
Br. line 3310' Lans 3322 B KC 3536
Viola 3576' Simp. 3627'
TD 3666 D & A

ABANDONED

MAY 1 1933

| | |
|----------------|----|
| Scout Cards | AD |
| Land Small Map | |
| Land Wall Map | B |
| Tracings | |
| France Map | |
| Pierce Map | |
| Misc. | |

| | |
|----------------|-----------|
| Scout Cards | <i>mm</i> |
| Land Small Map | |
| Land Wall Map | <i>B</i> |
| Tracings | |
| France Map | |
| Pierce Map | |
| Misc. | |

MAY 19 1953

Orig. Date