


Section 6 Township 21 Range 13-W

Well No. #1 Parrish

Company Derby Oil

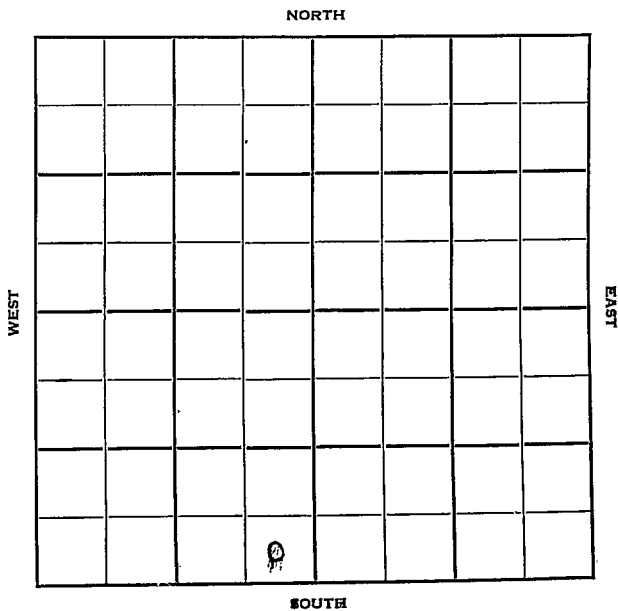

Sec. 6 Twp. 21 R. 13-W

Well No. #1 Parrish Farm

Derby Oil Company

Contractor

Rothgarn Pool


 Ft. from N. Line

330 Ft. from S. Line

330 Ft. from E. Line

 Ft. from W. Line

SE SE SW

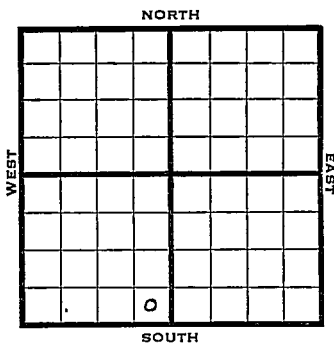

1950 Elev 1917 REPORT

7/12 Location

9/20 Oil Well TD 3670'
 8-5/8" @ 247'
 Heeb. 3200' Br Lime 3319'
 Lans. 3330'
 DST 3451-66 opn 15 min.
 Rec. 285' G&OCM
 Viola 3561' Arb. 3626'
 stain 3636-40 TD 3670'
 4 1/2" @ 3669'
 13/3634-37 21/3626-31 500 A
 S/13 1/2 BWPB for 7 hr. PB 3500
 30/3456-63 FU 65' oil in 45 min
 1000 A S/122 bo 4 hr.
 Comp. 646 BOPD

COMPLETED

Kansas

Map No. _____ Sec. 6 Twp. 21 R. 13WWell No. 1 Parrish

_____ Derby Oil _____ Company

_____ Contractor

SE SE SW

E1.1917
SECTION PLAT

_____ Ft. from N. Line

330 Ft. from S. Line330 Ft. from E. Line

_____ Ft. from W. Line



Stafford County

Location X

Rig up _____

Drilling and Remarks:

RECORD

Cased _____ in., _____ ft.

Sand _____

Gas _____

Oil _____

Total Depth _____

PRODUCTION

1st 24 hrs. Nat. _____

1st 24 hrs. after shot _____

Gas _____ Cu. Ft.

Dry Hole _____

Abandoned _____

Date

JUL 12 1950 19J. E. TYRA Scout

