


Section 6 Township 21 Range 13 W

Well No. # 1 Parrish

Company Don Jones et al

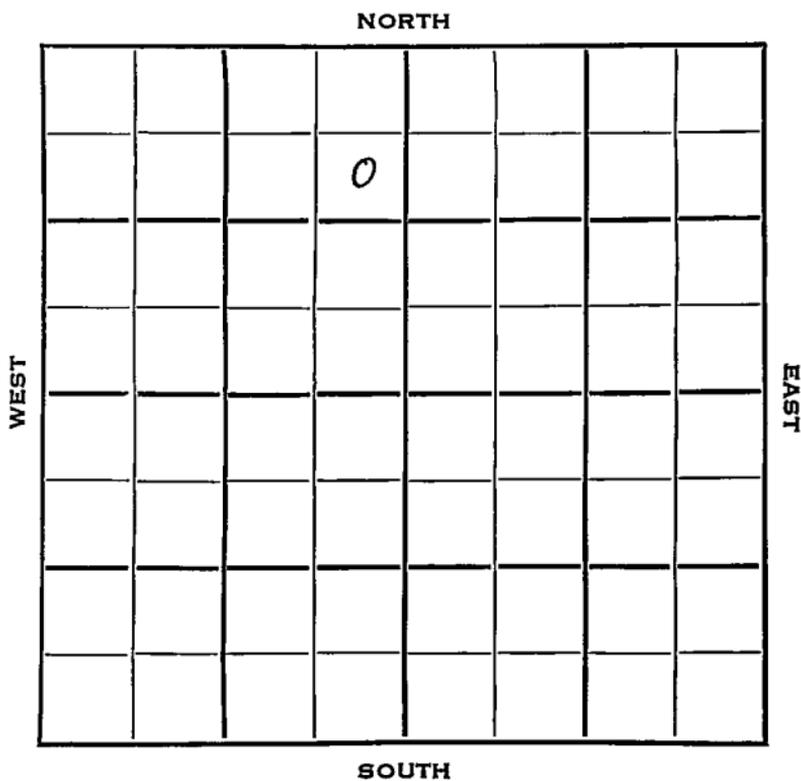

Stafford KANSAS

SEC.	TWP.	R.
6	21	13 W ✓

WELL NO. # 1 Parrish FARM

COMPANY Don Jones et al

CONTRACTOR Fleming & Woodman


Semi-Wildcat

990 Ft. from N. Line

Ft. from S. Line

380 Ft. from E. Line

Ft. from W. Line

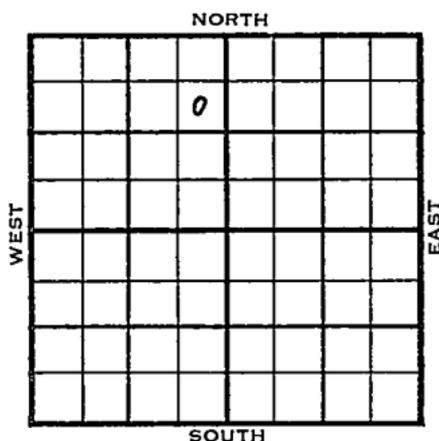

SE NE NW (Twin well)

	ELEVATION	REPORT
1954	1911'	

4/7

Spud 4-1-54
8" @ 328 Anhy 800
Drlg. 2259'

4/14

Spud 4-1-54
D&A
TD 3592'
8" @ 328'
Anhy 800', Br lime 3305', Lans 3316'
DST 3470-79', opn 15", rec. 10' mud,
Off
Arb. 3578'
DST 3579-83', opn 20", rec. 5' mud,
Off
DST 3580-92', opn 1 hr., rec. 165' SW
TD 3592'
D&A

ABANDONED

