


Section 6 Township 21 Range 13W

Well No. #1 Parrish

Company Petroleum Inc.

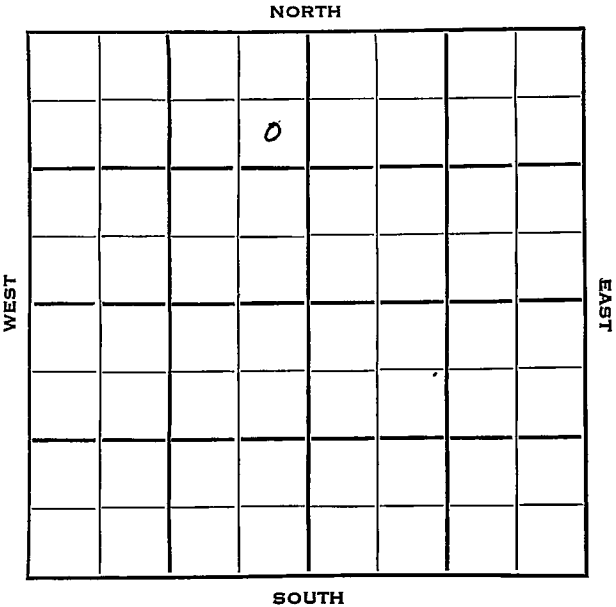

Sec. _____ Twp. _____ R. _____

Well No. #1 Parrish Farm

Petroleum, Inc. Company

Garvey Contractor

Wildcat


990 Ft. from N. Line

Ft. from S. Line

330 Ft. from E. Line

Ft. from W. Line

SE NE NW

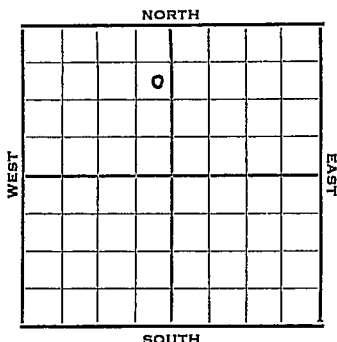

1953 Elev. 1912' REPORT

2/25 Spud 2-22-53
8" @ 219, WOC

3/12 Heeb 3188, Br li 3305, Lans
3316
DST 3468-80, 1 hr., 600' gas,
60' oil
Arb. 3572
DST 3573-78, 1 hr., 420' oil
1000#
DST 3583-3605, 1 hr., 970'
SW, 1060#
RTD 3622
5" @ 3621

3/19 CO 3600, 28/3575-81, 250A
wtr + SS0 sq.

3/26 PB 3579 S/2 GO plus 4 GWPH 250 A
13/3573-77 S/4 GO plus 4 GWPH
500 A S/35 BO plus 125 BWPD

4/2 D & A

4/8 Spud 2-22-53 D & A TD 3622
8" @ 210 Heeb 3188 Br lime 3305
Lans. 3316
DST 3468-80 open 1 hr. rec 600' gas,
60' oil Arb. 3572
DST 3573-78 open 1 hr. rec 420' oil
1000#
DST 3583-3605 open 1 hr. rec 970' SW
1060# TD 3622' 5" @ 3621'

OVER

1953

4/8

(Information continued)

CO to 3600 28/3575-81 250 A

wtr. ' & SSO PB 3579 S/2 GO

4 GWPH 250 A 13/3573-77

S/4 GO 4 GWPH 500 A

S/35 BOPD 12 1/2 BW

D & A


ABANDONED

County Stafford State Kansas
 Sec. 6 (Blk. 21) (Sur. 13W) Map No.

Operator Petroleum Inc.

Well No. 1 Farm Parrish

Elev. Location SE NE NW

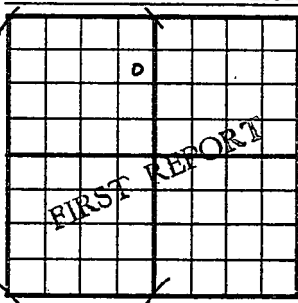

990 Ft. From N Line NW

330 Ft. From E Line Quarter

1st. Report FEB 25 1953

Completion

Remarks

Garvey - Contr.

Spudding Date 2-22-53

Drlg. Data


Wildcat

8" @ 219 WOC

FEB 27 1953

Scout Cards	_____
Land Small Map	_____
Land Wall Map	_____
Tracings	_____
France Map	_____
Pierce Map	_____
Misc.	_____

Drig. Data

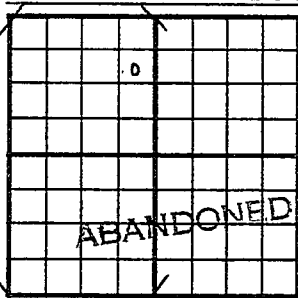County Stafford State KansasSec. 6 (Blk.
Twp.) 21 (Sur.
Rge.) 13W Map No. _____Operator Petroleum Inc.Well No. 1 Farm ParrishElev. 1912 Location SE NE NW990 Ft. From N Line NW330 Ft. From E Line Quarter

1st. Report _____

Completion APR 8 1953Remarks WildcatGarvie - Contr.Spudding Date 2-22-53Drlg. Data D & A TD 36228" @ 210 Heeb. 3188 Br. lime 3305Lans. 3316 . DST 3468-80 open 1 hr.Rec. 600' gas 60' oil Arb. 3572DST 3573-78 open 1 hr. Rec. 420' oil1000# DST 3583-3605 open 1 hr.Rec. 970' sw 1060# TD 36225" @ 3621 CO to 3600 28/ 3575-81250 A wtr & SSO PB 3579 S/ 2 go 4 gwph250 A 13/ 3573-77 S/ 4 go 4 gwph500 A S/ 35 bopd 125 bwD & A

J. G. McGEHEE

Scout Cards	77 77
Land Small Map	
Land Wall Map	38
Tracings	
France Map	
Field Map	
Other	

Adm 45 1953

Orig. Date