

Sec. 6 Twp. 21 R. 13 W ✓

Well No. # 2 Parrish Farm

Derby Oil Company

Peel Contractor

Dell


_____ Ft. from N. Line

330 Ft. from S. Line

990 Ft. from E. Line

_____ Ft. from W. Line

SW SE SW

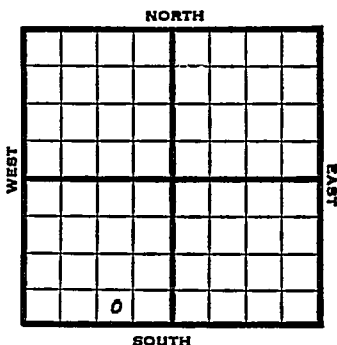

1951

Elev. 1915' REPORT

2/21

Location

5/2

Spud 3-4-51
 Oil Well TD 3624
 8" @ 275
 Heeb. 3202 Br. Lime 3319
 Lans. 3329
 DST 3445-3520 opn 1 hr
 Rec. 75' socm
 BKC 3542 Viola 3555
 Simp 3571 Arb. 3619-24
 4 1/2" @ 3620 TD 3624
 PB 3550 69/3481-3500 500 A
 S/16 bo 1 hr 1500 A
 S/11 bo 1 hr PB 3470
 22/3454-60 S/6 boph 1000 A
 S/7 boph CO to 3545 S/67
 bo in 15 hr Comp. 124 bopd 1% wtr

COMPLETE

