


Stafford

Section 6 Township 21 Range 14W

Well No. #1 Barrett

Company B & R Drlg.

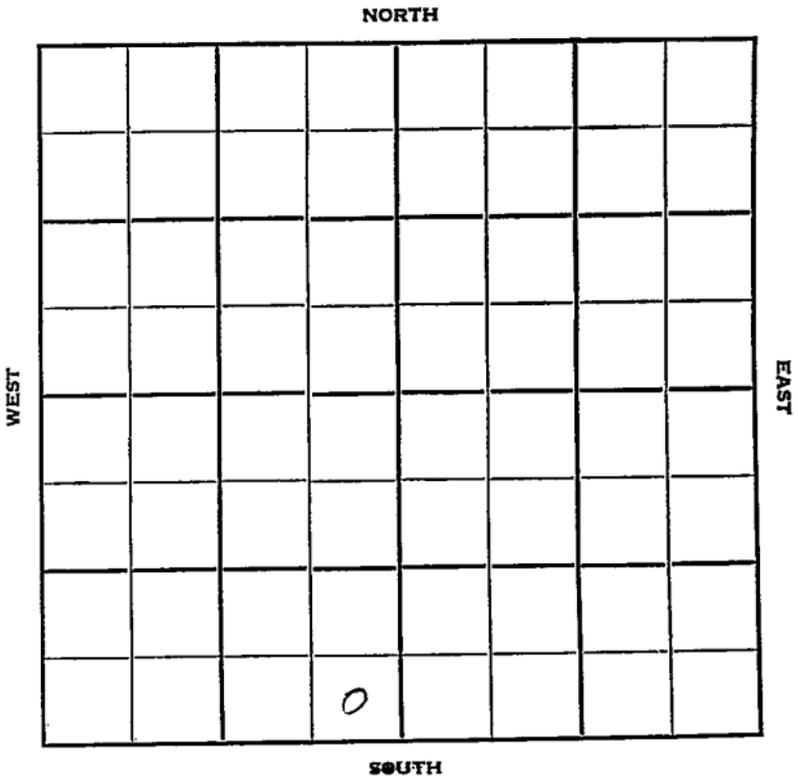

Stafford

Sec. 6 Twp. 21 R. 14 W ✓

Well No. # 1 Barrett Farm

B & R Drlg. Company

B & R Drlg. Contractor


         Ft. from N. Line

330 Ft. from S. Line

330 Ft. from E. Line

         Ft. from W. Line

SE SE SW

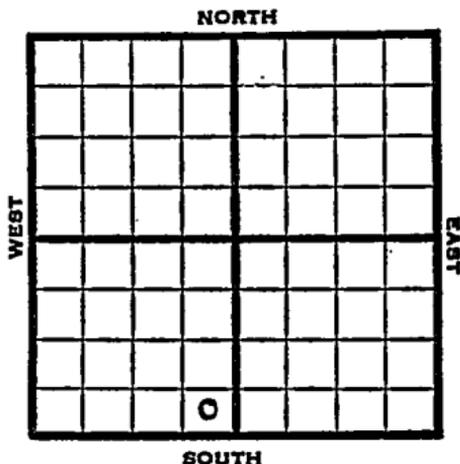

1951

Elev. 1932' REPORT

3/21

R U R

4/11

Spud 3-21-51

D&A TD 3806

8" @ 889'

Anhy 898 Heeb. 3280'

Br Line 3383 Lans. 3398

Cong. 3659' Viola 3674

Simp 3713 Arb. 3763-85 RTD

TD 3806 D&A

**ABANDONED**



