

FORM 51      Stafford

**KANSAS**

Section 6      Township 21      Range 11W

Well No. #1 Heneisen

Company Palmer Oil Company

|       |   |  |  |  |  |  |  |
|-------|---|--|--|--|--|--|--|
| NORTH |   |  |  |  |  |  |  |
| WEST  |   |  |  |  |  |  |  |
|       |   |  |  |  |  |  |  |
|       |   |  |  |  |  |  |  |
|       | 0 |  |  |  |  |  |  |
|       |   |  |  |  |  |  |  |
|       |   |  |  |  |  |  |  |
|       |   |  |  |  |  |  |  |
|       |   |  |  |  |  |  |  |
| SOUTH |   |  |  |  |  |  |  |
| EAST  |   |  |  |  |  |  |  |

Stafford

KANSAS

Sec. 6 Twp. 21 R. 11WWell No. #1 Hueisen FarmPalmer Oil Company Company

Contractor

Wildcat


Ft. from N. Line

330 Ft. from S. Line

Ft. from E. Line

330 Ft. from W. Line

SW SW NW

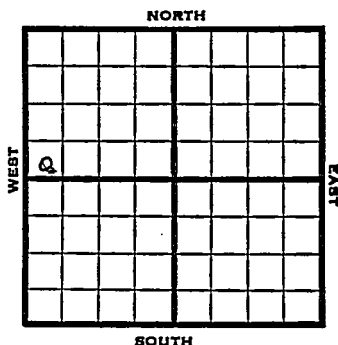

1953 Elev. 1928' REPORT

3/4 Spudded 3/2/53

3/12 Anhy 880  
 8" @ 884  
 Drlg. 3098'

3/18 Spud 3-2-53  
 D&A  
 TD 3830  
 Anhy 880,  
 8" @ 884  
 Heeb 3249, Br lime 3352, Lans  
 3363  
 DST 3391-3416, opn  $\frac{1}{2}$  hrs., rec.  
 25' mud, 40#  
 Cong 3544, Ero Arb 3761, Arb.  
 3780  
 TD 3830  
 D&A


**ABANDONED**

County Stafford State KansasSec. 6 (Blk.) 21 (Sur.) 14W Map No.Operator Palmer OilWell No. 1 Farm HeweisenElev. Location SE SW NW330 Ft. From S Line NW330 Ft. From W Line Quarter1st. Report MAR 4 1953

Completion

Remarks

Spudding Date 3-2-53Drig. Data Wildcat

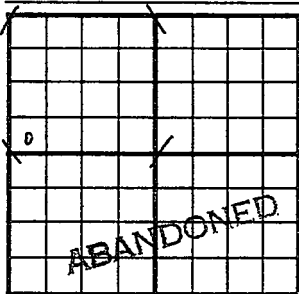County Stafford State KansasSec. 6 (<sup>Blk.</sup>21) (<sup>Sur.</sup>14W) Map No. Operator Palmer OilWell No. 1 Farm HeueisenElev. 1928 Location SW SW NW330 Ft. From S Line NW330 Ft. From W Line Quarter1st. Report Completion MAR 18 1953Remarks WildcatSpudding Date 3-2-53Drilg. Data D & A TD 3830Anhy 880 8" @ 884 Heeb. 3249Br. lime 3352 Lans. 3363 DST 3391-3416open  $\frac{1}{2}$  hr. Rec. 25' mud 40#Cong. 3544 EroArb. 3761 Arb. 3780TD 3830D. & A

J. G. McGEHEE