
FORM 51 Stafford KANSAS

Section 6 Township 21 Range 14W

Well No. #3 Frey "B"

Company Vickers Petroleum

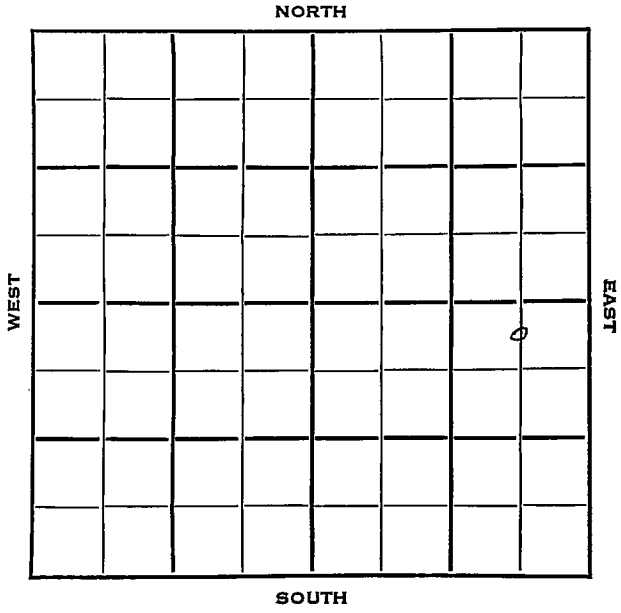

FORM 252-B
10M 8-51 TPCO.

KANSAS

Sec. 6 Twp. 21 Stafford R. 14W

Well No. #3 Frey "B" Farm

Vickers Petr. Company

Jayhawk Drlg. Contractor


330 Ft. from N. Line

Ft. from S. Line

660 Ft. from E. Line

Ft. from W. Line

C N L NE SE

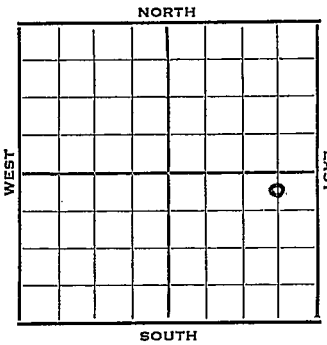

1953	Elev. 1922' REPORT
2/18	Location
2/26	8" @ 879 Anhy 874
3/12	Heeb 3250, Br li 3354, Heeb 3250, Br li 3354, Lans 3362, V 3620, Simp 3650, Arb 3695 RTD 3701 5" @ 3700
3/19	(Cor Arb 3689, RTD 3695, 5" @ 3694) - Steel line Cor. DD 3701 24/3694-3701
3/26	1000 A 500 A B/20 BO
4/2	NR
4/9	"
4/15	Spud 2-23-53 Oil Well TD 3701 8" @ 879 Anhy 874, Heeb 3250, Br lime 3354, Lans 3362, iola 3620, Simp 3650, Arb. 3689 TD 3695 5" @ 3694, DD 3701 24/3694-3701, 1000A, 500A, B/20 bo Comp. 327 bopd 15% wtr. COMPLETED

FORM 275 FOR SALE BY KANSAS BLUE PRINT CO.


County Stafford State Kansas

Sec. 6 (Blk. Twp.) 21 (Sur. Rge.) 14W Map No.

Operator Vickers Pet.

Well No. 3 Farm Frey "B"

Elev. Location C N L NE SE

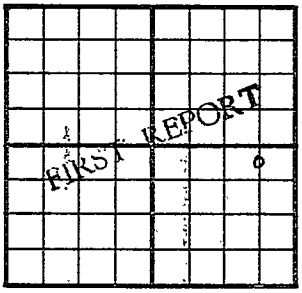

330 Ft. From N Line SE

660 Ft. From E Line Quarter

1st. Report FEB 18 1953

Completion

Remarks

Jayhawk Drlg. - Contr.

Spudding Date

Drlg. Data

Location

J. G. McGEHEE

FORM 275 FOR SALE BY KANSAS BLUE PRINT CO.


County Stafford State Kansas

Sec. 6 (Blk. Twp.) 21 (Sur. Rge.) 14W Map No.

Operator Vickers Pet.

Well No. 3 Farm Frey "B"

Elev. 1922 Location C N L NE SE

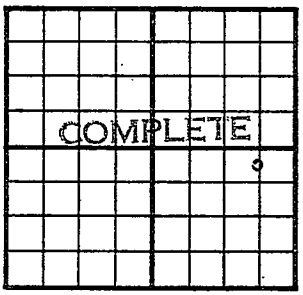

330 Ft. From N Line SE

660 Ft. From E Line Quarter

1st. Report

Completion APR 15 1953

Remarks

Jayhawk Drlg. - Contr.

Spudding Date 2-23-53

Drlg. Data Oil well TD 3701

8" @ 879 Anhy 874 Heeb. 3250

Br. lime 3354 Lans. 3362 Viola 3620

Simp. 3650 Arb. 3689 TD 3695 5" @ 3694

DD 3701 24/ 3694-3701 1000 A

500 A B/ 20 bo Comp. 327 bopd 15% wtr.

J. G. McGEHEE