

Pawnee County


FORM 51 10M 8-47

KANSAS

Section 6 Township 21 Range 15W

Well No. 3 Gross

Company Gulf

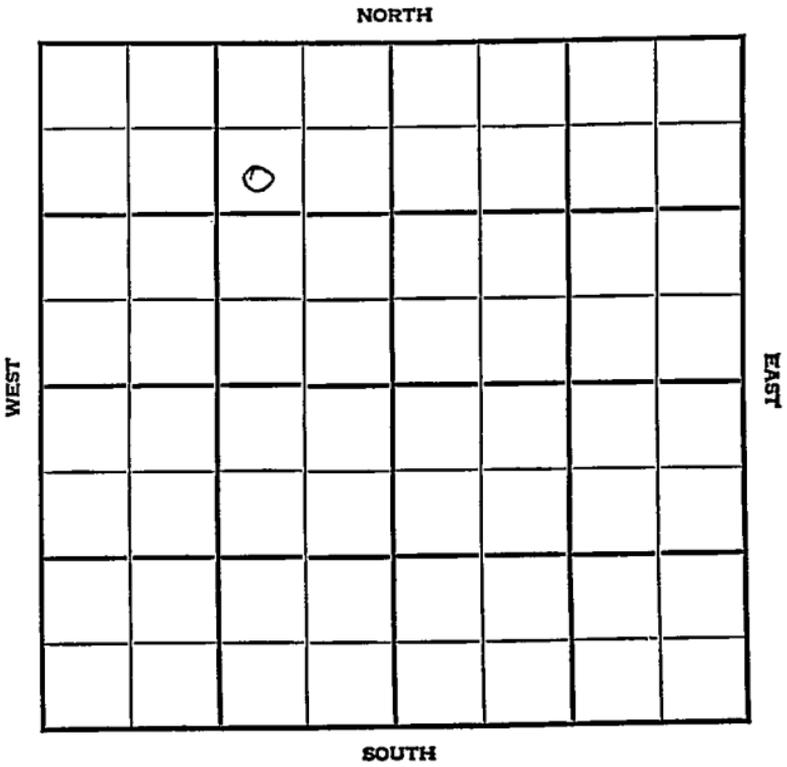

Sec. 6 Twp. 21 R. 15W

Well No. #3 Gross Farm

Gulf Company


Ash Creek

990 Ft. from N. Line

\_\_\_\_\_ Ft. from S. Line

990 Ft. from E. Line

\_\_\_\_\_ Ft. from W. Line

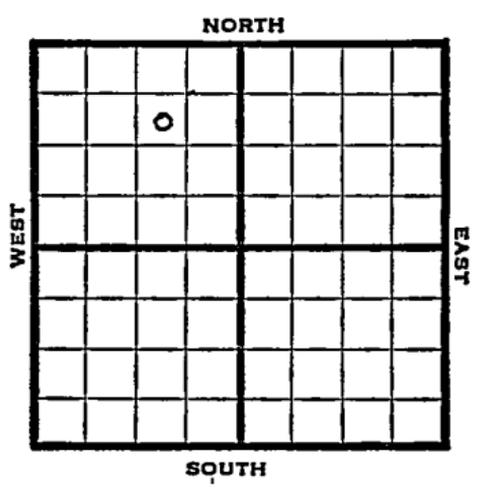

SW NE NW

1947	Elev. 1977' REPORT
12/17	Location
12/30	8" @ 996' Drlg. 1000'
1948	
1/7	Drlg. 3615'
1/14	Lansing 3419'
	Viola 3805'
	Arbuckle 3887'
	Granite 4399'
	TD 4415' Ruh csg
1/21	5" @ 4045' RUST
1/26	"
2/4	SWG
2/11	"
2/18	"
2/25	Granite 4399'
	5" @ 4045'
	SWG
	TD 4415'
	Abd.
	<b>ABANDONED</b>

Map No. \_\_\_\_\_ Sec. 6 Twp. 21 R. 15W

Well No. 3 Gross

Gulf Company

**FIRST REPORT**

Contractor

SW NE NW

**SECTION PLAT**

990 Ft. from N. Line

\_\_\_\_\_ Ft. from S. Line

990 Ft. from E. Line

\_\_\_\_\_ Ft. from W. Line

	o		

Pawnee County

Location X

Rig up \_\_\_\_\_

Drilling and Remarks:

**RECORD**

Cased \_\_\_\_\_ in., \_\_\_\_\_ ft.

Sand \_\_\_\_\_

Gas \_\_\_\_\_

Oil \_\_\_\_\_

Total Depth \_\_\_\_\_

**PRODUCTION**

1st 24 hrs. Nat. \_\_\_\_\_

1st 24 hrs. after shot \_\_\_\_\_

Gas \_\_\_\_\_ Cu. Ft.

Dry Hole \_\_\_\_\_

Abandoned \_\_\_\_\_

Date

DEC 17 1947 19

S. J. LEWIS Scout

*[Handwritten scribble]*

*[Handwritten scribble]*

Misc. Small Maps	<i>[initials]</i>
Cards	<i>[initials]</i>
Tracing	<i>[initials]</i>
France Map	<i>[initials]</i>
Scarborough Map	<i>[initials]</i>
Pierce Map	<i>[initials]</i>
Geological Dept.	
Pierce Plot Book	

*[Handwritten scribble]*

Map No. 82 Sec. 6 Twp. 21 R. 15W

Well No. 3 Gross

Gulf Company

**ABANDONED**

Contractor

SW NE NW

E11999  
SECTION PLAT

990 Ft. from N. Line

\_\_\_\_\_ Ft. from S. Line

990 Ft. from E. Line

\_\_\_\_\_ Ft. from W. Line

	4		

Pawnee County

Location \_\_\_\_\_

Rig up \_\_\_\_\_

Drilling and Remarks:

*Granite 4399*

*5' @ 4045*

*BWS*

**RECORD**

Cased \_\_\_\_\_ in., \_\_\_\_\_ ft.

Sand \_\_\_\_\_

Gas \_\_\_\_\_

Oil \_\_\_\_\_

Total Depth 4415

**PRODUCTION**

1st 24 hrs. Nat. \_\_\_\_\_

1st 24 hrs. after shot \_\_\_\_\_

Gas \_\_\_\_\_ Cu. Ft.

Dry Hole \_\_\_\_\_

Abandoned \_\_\_\_\_

Date

FEB 25 1948

19

S. J. LEWIS

Scout

Misc. Small Maps	.....
Cards	<i>Ruth</i>
Tracing	<i>[Signature]</i>
France Map	<i>[Signature]</i>
Scarborough Map	<i>[Signature]</i>
Pierce Map	<i>[Signature]</i>
Geological Dept.	.....
Pierce City Book	.....