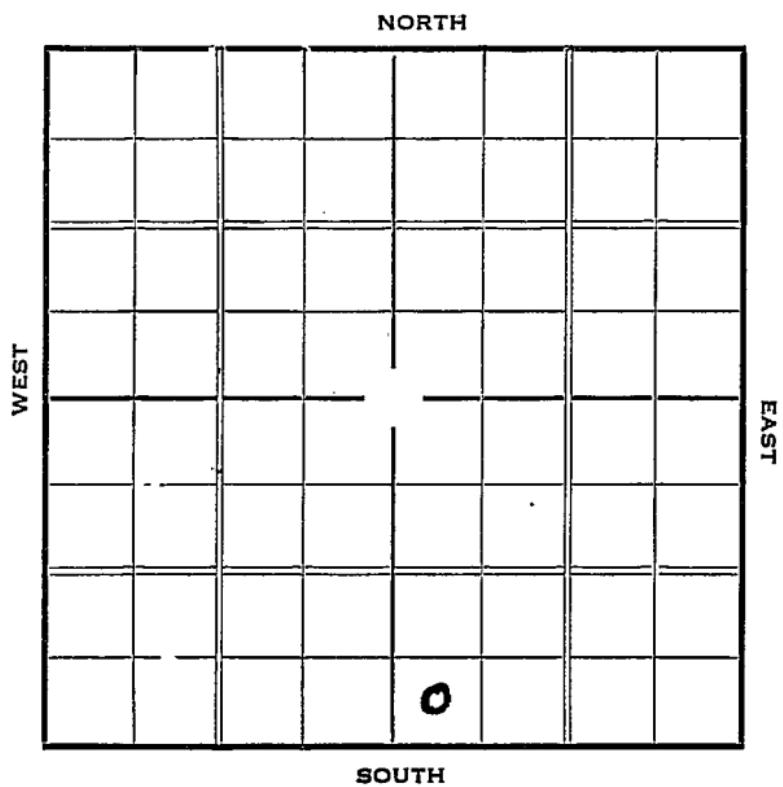


Section 6 Township 21 Range 7-WWell Number 2 Hughes "B"Company Atlantic Ref.

Sec. 6 Twp. 21 R. 7-7

Well No. #2 Hughes "B" Farm

Atlantic Ref. Company

_____Ft. from N. Line

330 Ft. from S. Line

Ft. from E. Line

330 Ft. from W. Line

Elev. 1632


Date	REPORT
1937	
4/7	Rig
4/16	10" @ 205'. Drdg. 1575'.
4/23	Drdg. 3106'.
4/30	4 11
	~ ~
5/5	Chat 3334'.
	T.D. 3342 $\frac{1}{2}$ '.
	Pot. 1083 Nat.
	COMPLETED

KANSAS

Rice

Map No. _____ Sec. 6 Twp. 21 R. 7W.

Well No. 2 Hughes "B"Atlantic Ref.

Company

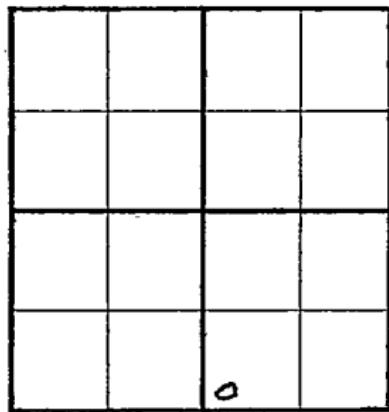
Contractor

SECTION PLAT

____ Ft. from N. Line

330 Ft. from S. Line

____ Ft. from E. Line

330 Ft. from W. Line

FIRST REPORT

Location _____

RECORD

Cased in., ft.

Sand _____

Gas _____

Oil _____

Total Depth _____

PRODUCTION

1st 24 hrs. Nat. _____

1st 24 hrs. after shot _____

Gas Cu. Ft. _____

Dry Hole _____

Abandoned _____

Date

APR 7 1937 19

S. J. LEWIS Scout

Rice KANSAS

Map No. 49 Sec. 6 Twp. 21 R. 7^WWell No. 2 - Hughes "B"
atlantic

Company

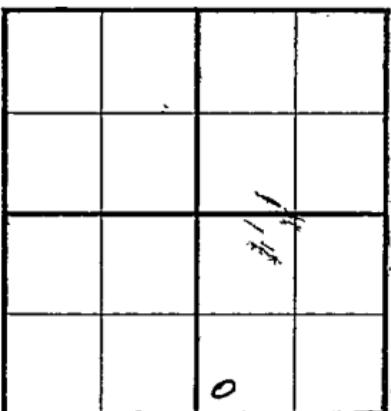
Contractor

COMPLETED**SECTION PLAT**

____ Ft. from N. Line

330 Ft. from S. Line

____ Ft. from E. Line

330 Ft. from W. Line

Location _____

RECORD

Cased in., ft.

Sand Chat 3334

Gas _____

Oil _____

Total Depth 3342 1/2**PRODUCTION**

1st 24 hrs. Nat. _____

1st 24 hrs. after shot _____

Gas Cu. Ft. _____

Dry Hole _____

Abandoned _____

Date

MAY 5 - 1937 19H. D. Hatfield Scout