

KANSAS

Form 51-5M-7-39-Palace

Rice

Section 6 Township 21 Range 7-W

Well No. #1 Oden

Company Eldorado Refining

Wherry Pool

NORTH

			0				

WEST

EAST

SOUTH

KANSAS


Rice

Sec. 6 Twp. 21 R. 7-WWell No. #1 Oden FarmEldorado Refg. Company

(Wherry)

330 Ft. from N. Line Ft. from S. Line330 Ft. from E. Line Ft. from W. Line

Ele v. 1629

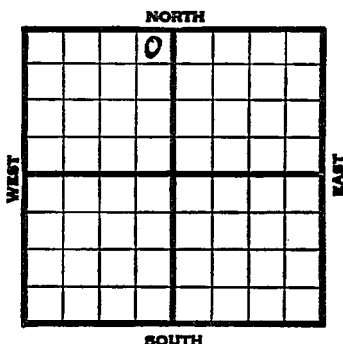

1940	REPORT
3/13	Rotary.
3/21	15" - 102' Drlg. 611'
3/28	Drlg. 2521'
4/4	Fishing 2603'
4/12	Whipstock 2230' Drlg. by.
4/18	Lost hole. Skid rig 50' East.
	13" - 101' Drlg. 630'
4/25	Drlg. 2070'
5/2	3295' run 7".
5/9	Cong. 3319' 5" liner 3319'
	TD 3354' SD.
5/16	" "
5/23	" "
5/29	" "
6/6	" "
6/12	Cong. 3319'
	7" - 3295'
	5" liner 3319'
	T.D. 3354'
	ABANDONED

Rice


KANSAS

Map No. 49 Sec. 6 Twp. 21 R. 7WWell No. 1 OdenEldorado Refining Company

Contractor

FIRST REPORT
NE NW

SECTION PLAT

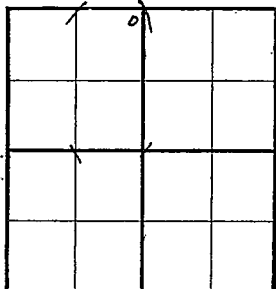330 Ft. from N. Line Ft. from S. Line330 Ft. from E. Line Ft. from W. Line

WHERRY POOL

Location Rig up

Drilling and Remarks:

Rotary

RECORD

Cased in., ft.Sand Gas Oil Total Depth

PRODUCTION

1st 24 hrs. Nat. 1st 24 hrs. after shot Gas Cu. Ft.Dry Hole Abandoned

Date

MAR 13 1940

S. J. LEWIS

Scout

Map No. 49 Sec. 6 Twp. 21 R. 7WWell No. 1 OdenEldorado Refining Company

Contractor

ABANDONED

NE NW

330 Ft. from N. Line Ft. from S. Line330 Ft. from E. Line Ft. from W. Line

WHERRY POOL

SECTION PLAT

Location Rig up

Drilling and Remarks:

*Core 3319**7" 3295**5" 4122 3319*

RECORD

Cased in., ft.Sand Gas Oil Total Depth 3254

PRODUCTION

1st 24 hrs. Nat. 1st 24 hrs. after shot Gas Cu. Ft.Dry Hole Abandoned

Date

JUN 12 1940S. J. LEWIS Scout