


# KANSAS

Section 6 Township 21 Range 9-W

Well No. #1 Shepherd

Company Rocket Drilling etal  
(Wildecat)

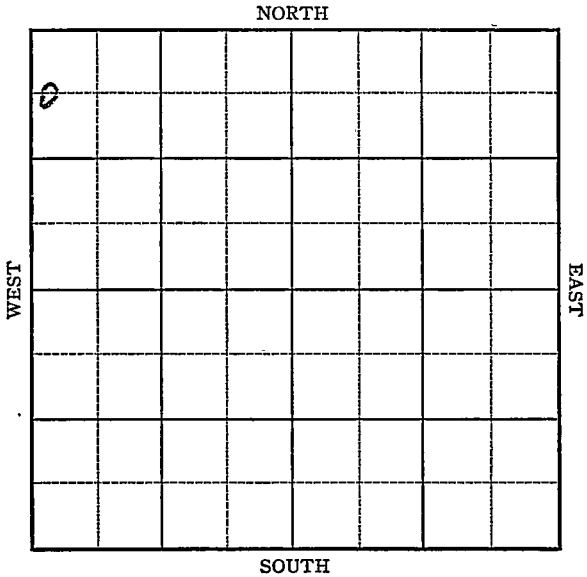



Map No. \_\_\_\_\_ Sec. 6 Twp. 21 R. 9W

Well No. 1 Shepherd


Rocket Drilling etal Company

Contractor

~~FIRST REPORT~~

SECTION PLAT

660 C W L NW NW  
Ft. from N. Line  
\_\_\_\_ Ft. from S. Line  
\_\_\_\_ Ft. from E. Line  
330 Ft. from W. Line

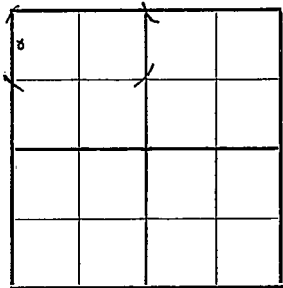

WILDCAT

Location \_\_\_\_\_

Rig up \_\_\_\_\_

Drilling and Remarks:  
Rotary

RECORD

Cased \_\_\_\_\_ in., \_\_\_\_\_ ft.  
Sand \_\_\_\_\_  
Gas \_\_\_\_\_  
Oil \_\_\_\_\_  
Total Depth \_\_\_\_\_

PRODUCTION

1st 24 hrs. Nat. \_\_\_\_\_  
1st 24 hrs. after shot \_\_\_\_\_  
Gas \_\_\_\_\_ Cu. Ft.  
Dry Hole \_\_\_\_\_  
Abandoned \_\_\_\_\_

Date

AUG 6 1941 19

S. J. LEWIS Scout

Map No. \_\_\_\_\_ Sec. 6 Twp. 21 R. 9WWell No. 1 Shepherd  
Rocket Drilling etal Company~~ABANDONED~~

Contractor

C W L NW NW

660 Ft. from N. Line

\_\_\_\_\_ Ft. from S. Line

\_\_\_\_\_ Ft. from E. Line

330 Ft. from W. Line

## SECTION PLAT

<u>2</u>			

WILDCAT

Location \_\_\_\_\_

Rig up \_\_\_\_\_

Drilling and Remarks:

*Cor 43375**Woshows*

## RECORD

Cased \_\_\_\_\_ in., \_\_\_\_\_ ft.

Sand \_\_\_\_\_

Gas \_\_\_\_\_

Oil \_\_\_\_\_

Total Depth 3427

## PRODUCTION

1st 24 hrs. Nat. \_\_\_\_\_

1st 24 hrs. after shot \_\_\_\_\_

Gas \_\_\_\_\_ Cu. Ft.

Dry Hole \_\_\_\_\_

Abandoned \_\_\_\_\_

Date

AUG 27 1941 19

S. I. LEWIS Scout