

Map No. KANSAS Sec. 6 Twp. 21 R. 9-W

Well No. 1-Stout Farm
Skiles et al Company


 Ft. from N. Line

330 Ft. from S. Line

330 Ft. from E. Line

 Ft. from W. Line

Elev. 1694

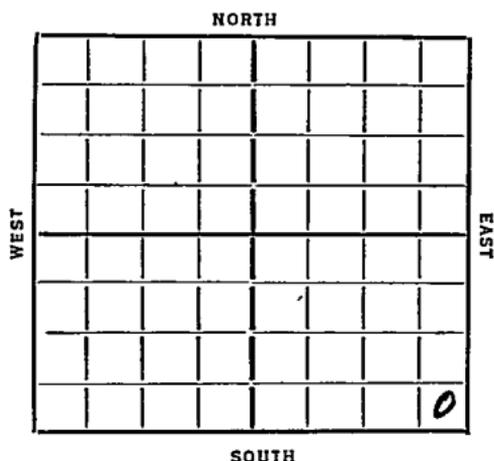

Date 1936	REPORT
3/25	Ponds
4/2	Rig.
4/10	--4/16--4/23--
4/30	Spud.
5/7	10" @ 785'. Drlg. 1615'.
5/14	Drlg. 2180'.
5/21	S.G. 2465-67'. 1 M. gas. Drlg. 2468
5/28	Drlg. 2644'.
6/4	Drlg. 2759'.
6/11	Drlg. 3150'.
6/24	/36-Sil. 3369'.
	H.F.W. 3374'.
	T.D. 3374'.
	D & A
	ABANDONED

KANSAS

Map No. 49 Sec. 6 Twp. 21 R. 9 N

Well No. 1 Stout

Skiles et al Company

Contractor

SECTION PLAT

..... Ft. from N. Line

330 Ft. from S. Line

330 Ft. from E. Line

..... Ft. from W. Line

FIRST REPORTS

RECORD

Location.....

Cased..... in., ft.

Rig up.....

Sand.....

Drilling and Remarks:

Gas.....

Ponds

Oil.....

Total Depth.....

PRODUCTION

1st 24 hrs. Nat.....

1st 24 hrs. after shot.....

Gas..... Cu. Ft.

Dry Hole.....

Abandoned.....

Date

3/25/26 192.....

S. J. LEWIS

Scout

Map No. 419 Sec. 6 Twp. 21 R. 9W

Well No. 1 Stout

Skiles et al Company

Contractor

SECTION PLAT

			0

_____ Ft. from N. Line

320 Ft. from S. Line

320 Ft. from E. Line

_____ Ft. from W. Line

ABANDONED

RECORD

Location _____

Cased _____ in., _____ ft.

Rig up _____

Sand _____

Drilling and Remarks:

Gas _____

Sil 3369

Oil _____

Total Depth 3374

NFW 3374

PRODUCTION

JFH

1st 24 hrs. Nat. _____

1st 24 hrs. after shot _____

Gas _____ Cu. Ft.

Dry-Hole _____

Abandoned _____

Date

JUN 24 1936₁₉

S. J. LEWIS Scout