


Section 6 Township 21 Range 11 W

Well No. #2 Beck

Company Veeder Supply & Devel. Co.

NORTH

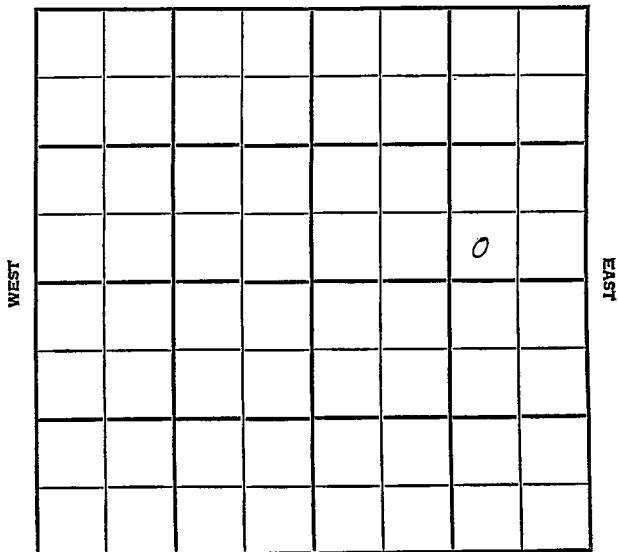

SOUTH

Stafford

KANSAS

SEC. 6	TWP. 21	R. 11W
-----------	------------	-----------

WELL NO. #2 Beck FARM

COMPANY Veeder Supply & Devel Co.

CONTRACTOR Co. Tools  
SW Kowalsky


\_\_\_\_\_ Ft. from N. Line

\_\_\_\_\_ Ft. from S. Line

\_\_\_\_\_ Ft. from E. Line

\_\_\_\_\_ Ft. from W. Line

SW SE NE

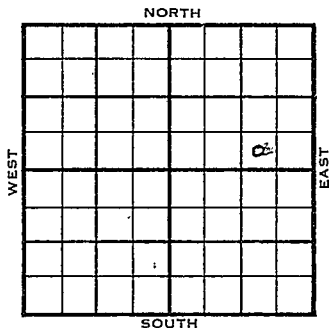

1955 ELEVATION 1822' REPORT

8/31 Location  
9-14 Comm. 9-1-55  
8 5/8 " @ 250 w/150;  
DST 3470-90 op 1 hr. ,rec 45' dm,  
BHP 620# 20"; no log  
D & A  
Tops                      Depth  
Anh.                      570  
H.                          3013  
Tr.                        3136  
L.                         3153  
C.                         3404  
A                          3468  
T.D. 3500'

**ABANDONED**

County Stafford Elev. \_\_\_\_\_  
 Sec. 6 Twp. 21 Rge. 11W  
 Company Veeder Supply & Devel. Co.  
 FarmName Beek No. 2

Co.  
Lse.  
No.  
Sec.  
T.  
R.

TOPS	DEPTH	LOG	DATUM
Anh.			
T.P.			
H.			
Tr.			
Dg.			
Bl.			
L.			
K.C.			
B.K.C.			
Ce.			
C.			
M.			
M.			
K.			
Mz.			
Me.			
V.			
S.			
S.			
A.			
R.			
Pe.			
G.			
T.D.			

Loc. in Sec. \_\_\_\_\_  
**SW SE NE**  
 Geol. \_\_\_\_\_  
 Contr. \_\_\_\_\_  
**Co. tools**  
 Pool \_\_\_\_\_  
**SW Kowalsky**  

<b>FIRST REPORT</b>		0
		0
<b>AUG 3</b>		<b>55</b>

Date Comm. \_\_\_\_\_

**Location**

*Handwritten scribbles and initials*

County Stafford Elev. 1822  
 Sec. 6 Twp. 21S Rge. 11W  
 Company Veeder Supply & Devel. Co.  
 FarmName Beck No. 2

TOPS	DEPTH	LOG	DATUM	Loc. in Sec.
Anh.	570			SW SE NE
Tr.				
H.	3013		1197	
Tr.	3136		1311	
Dg.				
Bl.				
L.	3153		1331	Geol.
K.C.				Contr.
B.K.C.				Co. tools
Ce.				Pool
C.	3404		1582	SW Kowalsky
M.				
M.				
K.				
Mz.				
Mq.				
V.				
S.				
S.				
A	3468		1646	ABANDONED
R.				
PE.				
G.				
T.D.	3500			

Date Comm. 9-1-55 SEP 1 4 1955

8-5/8" 250 w/150; DST 3470-90 op 1 hr.  
rec. 45' dm, BHP 620# 20"; no log

D & A

Co.

Lse.

No.

Sec.

T.

R.