


Section 6 Township 21 Range 11W

Well No. #4 Deitz

Company Veeder Supply

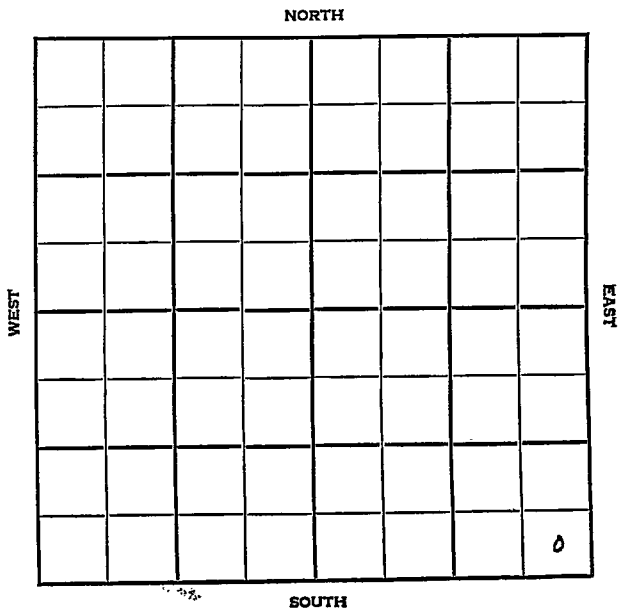

Stafford KANSAS

SEC. <p style="text-align: center;">6</p>	TWP. <p style="text-align: center;">21</p>	R. <p style="text-align: center;">11 W</p>
WELL NO.		
# 4 Deitz		FARM
COMPANY		
Veeder Supply		
CONTRACTOR		


\_\_\_\_\_ Ft. from N. Line

330 \_\_\_\_\_ Ft. from S. Line

330 \_\_\_\_\_ Ft. from E. Line

\_\_\_\_\_ Ft. from W. Line

SE SE SE

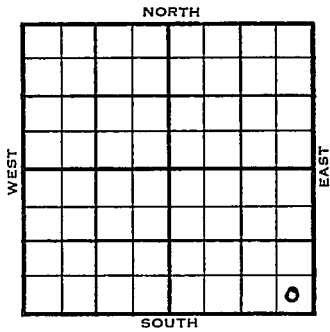

1955	ELEVATION	REPORT
	1807'	
1/19		Spud 1-15-55 8" @ 237 Anhy 570 Drlg. 1460'
2/2		Spud 1-15-55 - D&A TD 3526' 8" @ 237' Anhy 570' DST 3197-3245', opn 1 hr., rec. 30' OCM, 40# DST 3265-3335', opn 1 hr., rec. 28' oil spk mud, Heeb. 3000', Br lime 3123', Lans 3141, Simp. 3399', Arb. 3429' DST 3434-56', opn 1 hr., rec. 750' gas, 30' SOCM, 480# DST 3435-70', opn 2 hrs., rec. 130' GCM, 120' SO&GCM, 430# TD 3526' D&A
<b>ABANDONED</b>		



