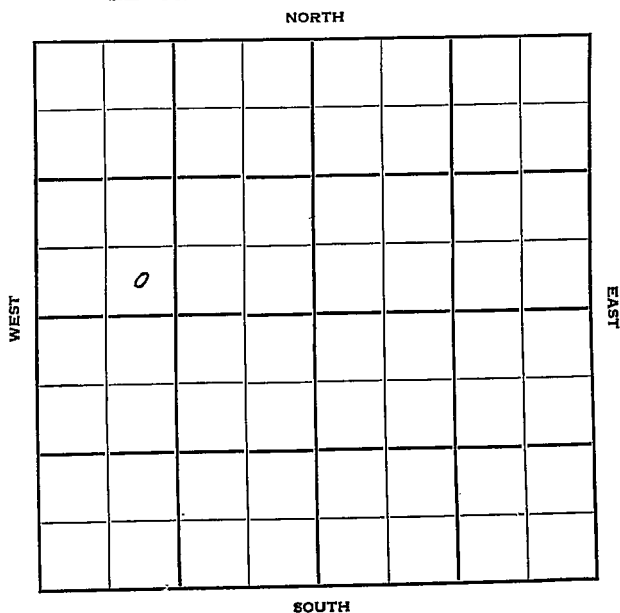


KANSAS

Stafford

Section 6 Township 21 Range 11-WWell No. #1 FischerCompany Phillips & Hanson
Wildcat

6

21

11W

Sec. _____ Twp. _____ R. _____

Well No. #1 Fischer Farm _____

Phillips & Hanson Company _____

Contractor _____

Wildcat

Ft. from N. Line

440'


Ft. from S. Line

Ft. from E. Line

990'

Ft. from W. Line

SE SW NW

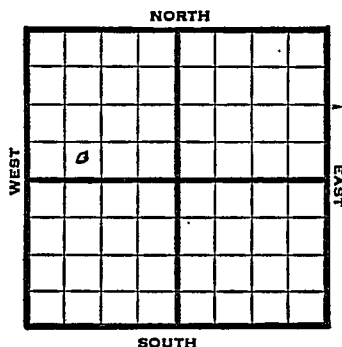

1950

Elev 1825' REPORT

3/8

RUR

4/26

TD 3461'

8"@ 275'

Anhy 600'

Topeka 2740'

Heebner 3014'

Br Lime 3136'

Lans 3158'

SO 3283-97'

3328-43'

Cong 3401'

Simp sh 3409'

Simp sd 3420'

Arb. 3424'

TD 3433

5"@ 3425'

DD 3439'

Swab 2 boph

2000 A @ 3433

Swab $\frac{1}{2}$ boph

DD 3461

Swab 5 boph 7 hrs.

1000 A

Comp 202 BOPD

Comp

COMPLETED


Kansas

Wildcat

Map No. _____ Sec. 6 Twp. 21 R. 11WWell No. 1 Fischer_____
Phillips & Hanson Company_____
Contractor

SE SW NW

SECTION PLAT

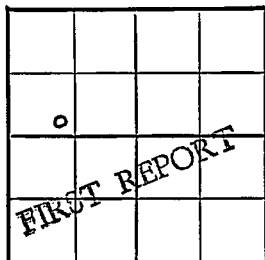_____
Ft. from N. Line440 Ft. from S. Line_____
Ft. from E. Line990 Ft. from W. Line

Stafford County

Location _____

Rig up _____

Drilling and Remarks:

R U R

RECORD

Cased _____ in., _____ ft.

Sand _____

Gas _____

Oil _____

Total Depth _____

PRODUCTION

1st 24 hrs. Nat. _____

1st 24 hrs. after shot _____

Gas _____ Cu. Ft.

Dry Hole _____

Abandoned _____

Date

MAR 8

19

J. E. TYRA

Scout

Scout Cards
Land Small Map
Land Wall Map
Tracings
French Map
Picture Map
Misc.

APR 10 1950

43

Kansas


Wildcat

Map No. _____ Sec. 6 Twp. 21 R. 11WWell No. 1 FischerPhillips & Hansen

Company

Contractor

SE SW NW

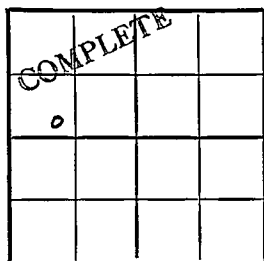E-1. 1825
SECTION PLAT

_____ Ft. from N. Line

440

_____ Ft. from S. Line

_____ Ft. from E. Line

990

_____ Ft. from W. Line

Stafford County

Location _____

Rig up _____

Drilling and Remarks:

8" c 275
 anhy 600
 Injeks 2740
 Reelner 3014
 Br line 3136
 Lams. 3158
 SO 3283-97

Date

3328-43

RECORD

Cased _____ in., _____ ft.

Sand _____

Gas _____

Oil _____

Total Depth 3461

PRODUCTION

1st 24 hrs. Nat. _____

1st 24 hrs. after shot _____

Gas _____ Cu. Ft.

Dry Hole _____

Abandoned _____

APR 26 195019J. E. TYRA

Scout




Camp. 202 202

1000 A
Sunk 5 202
202

DD 3461

Sunk 2 202

2000 A
DD 3433

Sunk 2 202

DD 3433

S.C.

T.D.

all.

Camp. 202
Sunk 202
all.

3401

Scout Cards	3433
Land Small Map	3425
Land Wall Map	3433
Tracings	3424
France Map	3420
Pierce Map	3409
Misc.	