


Section 6 Township 21 Range 11W

Well No. #1 Peterson

Company Veeder Supply

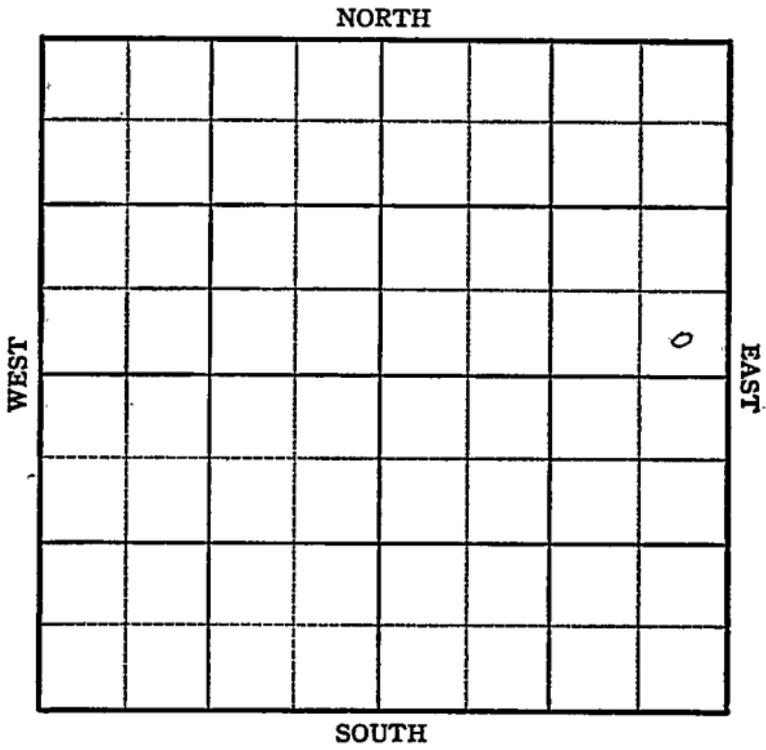

6

21

Sec. \_\_\_\_\_ Twp. \_\_\_\_\_ R. \_\_\_\_\_

#1 Peterson

Well No. \_\_\_\_\_ Farm \_\_\_\_\_

Veeder Supply

Company \_\_\_\_\_

Wildcat

Contractor \_\_\_\_\_

\_\_\_\_\_ Ft. from N. Line

330'


\_\_\_\_\_ Ft. from S. Line

330'

\_\_\_\_\_ Ft. from E. Line

\_\_\_\_\_ Ft. from W. Line

SE SE NE

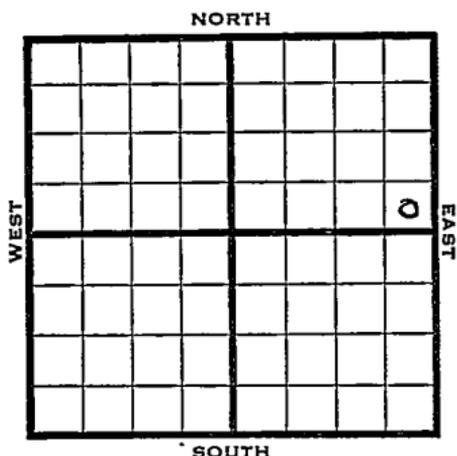

1950

Elev 1812' REPORT

3/15

MIM

4/12

TD 3475'  
8 5/8" @ 265'

Lans 3143'

Cong 3400'

Simp 3406'

Arb. 3419-24'

5" @ 3420'

D&A

Aband.

**ABANDONED**

Kansas

Map No. \_\_\_\_\_ Sec. 6 Twp. 21 R. 11WWell No. 1 Peterson

\_\_\_\_\_ Veeder Supply \_\_\_\_\_ Company

\_\_\_\_\_ Contractor

SE SE NE

## SECTION PLAT


\_\_\_\_\_ Ft. from N. Line

330

\_\_\_\_\_ Ft. from S. Line

330 Ft. from E. Line

\_\_\_\_\_ Ft. from W. Line

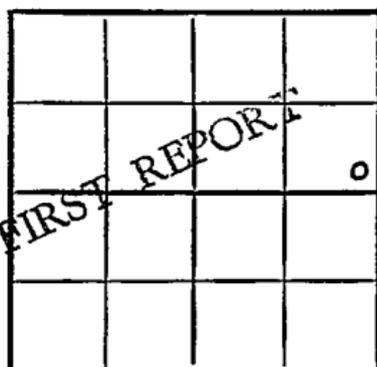

Stafford County

Magnolia farmout

Location \_\_\_\_\_

Rig up \_\_\_\_\_

Drilling and Remarks:

M I M

RECORD  $\frac{S}{2}$  NE

Cased \_\_\_\_\_ in., \_\_\_\_\_ ft.

Sand \_\_\_\_\_

Gas \_\_\_\_\_

Oil \_\_\_\_\_

Total Depth \_\_\_\_\_

## PRODUCTION

1st 24 hrs. Nat. \_\_\_\_\_

1st 24 hrs. after shot \_\_\_\_\_

Gas \_\_\_\_\_ Cu. Ft.

Dry Hole \_\_\_\_\_

Abandoned \_\_\_\_\_

Date

MAR 15 1959J. E. TYRA Scout

Map No. \_\_\_\_\_ Sec. 6 Twp. 21 R. 11WWell No. 1 Peterson

\_\_\_\_\_ Veeder Supply \_\_\_\_\_ Company

\_\_\_\_\_ Contractor

SE SE NE

*E. 1812*  
SECTION PLAT

\_\_\_\_\_ Ft. from N. Line

330 Ft. from S. Line330 Ft. from E. Line

\_\_\_\_\_ Ft. from W. Line

	ABANDONED		
			o

Stafford County

Location \_\_\_\_\_

Rig up \_\_\_\_\_

Drilling and Remarks:

*8 5/8" @ 265*  
*Lenz 3143*  
*Cong 3400*  
*Simp 3406*  
*Sub 3419-24*  
*5" @ 3420*  
*DJA*

## RECORD

Cased \_\_\_\_\_ in., \_\_\_\_\_ ft.

Sand \_\_\_\_\_

Gas \_\_\_\_\_

Oil \_\_\_\_\_

Total Depth 3473

## PRODUCTION

1st 24 hrs. Nat. \_\_\_\_\_

1st 24 hrs. after shot \_\_\_\_\_

Gas \_\_\_\_\_ Cu. Ft.

Dry Hole \_\_\_\_\_

Abandoned \_\_\_\_\_

Date

APR 12 1950

19

J. E. TYRA

Scout